

Ruler

Line Path Polygon Circle 3D path 3D polygon

Measure the distance between two points on the ground

Map Length: 297.48 Feet


Ground Length: 297.54

Heading: 65.30 degrees

☒ Mouse Navigation

Save Clear



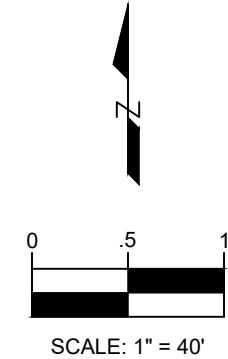

ARCHITECT

WALKER ARCHITECTS
2035 NW 13TH STREET
GAINESVILLE, FL 32609
352.672.6448 AA26002009

MEPF ENGINEER

MITCHELL GULLEDGE ENGINEERING, INC.
204 SW 4TH AVENUE
GAINESVILLE, FL 32601
352.745.3991

STRUCTURAL ENGINEER


WALTER P. MOORE
201 E KENNEDY BLVD #700
TAMPA FL 33602
813.221.2424

CIVIL ENGINEER

GEORGE & ASSOCIATES CONSULTING ENGINEERS, INC.
1967 COMMONWEALTH LN., SUITE 200
TALLAHASSEE, FL 32302
850.521.0344

TO THE BEST OF MY KNOWLEDGE, THESE DRAWINGS
AND SPECIFICATIONS COMPLY WITH THE APPLICABLE
MINIMUM BUILDING CODES AND THE APPLICABLE FIRE-
SAFETY STANDARDS AS DETERMINED BY THE LOCAL
AUTHORITY IN ACCORDANCE WITH FBC SECTION 110.8
AND CHAPTER 633 OF THE FLORIDA STATUTES.

SEAL AND SIGNATURE

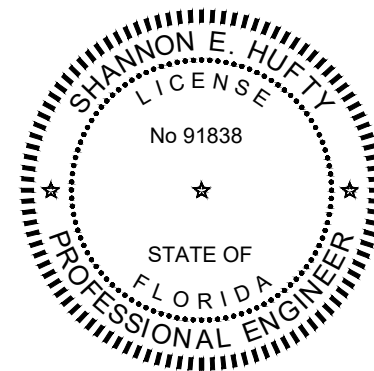

SHANNON E. HUFTY, PE
LICENSE NO.: 91838

SUBMITTAL:	ISSUE DATE:
100% CONSTRUCTION DOCUMENTS	08/24/2026

REVISION	DESCRIPTION	DATE
----------	-------------	------

**FLORIDA STATE
UNIVERSITY
ENERGY
RESEARCH
FACILITY**

FLORIDA STATE UNIVERSITY
2000 LEVY AVE, TALLAHASSEE,
FLORIDA 32310


KEY PLAN

DRAWING TITLE:

AUTOTURN EXHIBIT

PROJECT NO.:	26-5635	DRAWN BY:	
		CHECKED BY:	KRM

C 801

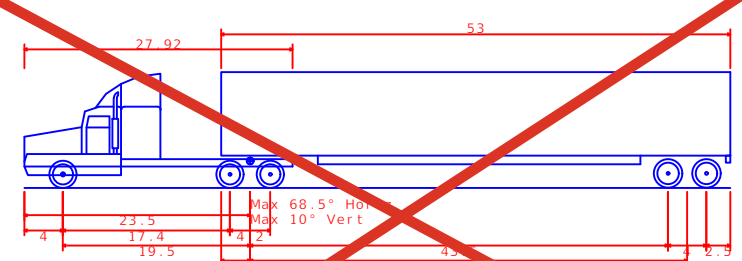


WB-67 - Interstate Semi-Trailer
Overall Length 73'-0\"/>

SCALE: 1" = 40'

(12) 3" 45s

**PROPOSED U.G. PIPE LAYOUT
09/2026**

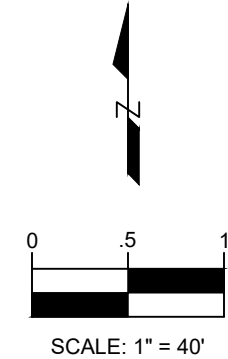

ARCHITECT

WALKER ARCHITECTS
2035 NW 13TH STREET
GAINESVILLE, FL 32609
352.672.6448 AA26002009

MEPF ENGINEER

MITCHELL GULLEDGE ENGINEERING, INC.
204 SW 4TH AVENUE
GAINESVILLE, FL 32601
352.745.3991

STRUCTURAL ENGINEER


WALTER P. MOORE
201 E KENNEDY BLVD #700
TAMPA FL 33602
813.221.2424

CIVIL ENGINEER

GEORGE & ASSOCIATES CONSULTING ENGINEERS, INC.
1967 COMMONWEALTH LN., SUITE 200
TALLAHASSEE, FL 32302
850.521.0344

TO THE BEST OF MY KNOWLEDGE, THESE DRAWINGS
AND SPECIFICATIONS COMPLY WITH THE APPLICABLE
MINIMUM BUILDING CODES AND THE APPLICABLE FIRE-
SAFETY STANDARDS AS DETERMINED BY THE LOCAL
AUTHORITY IN ACCORDANCE WITH FBC SECTION 110.8
AND CHAPTER 633 OF THE FLORIDA STATUTES.

SEAL AND SIGNATURE

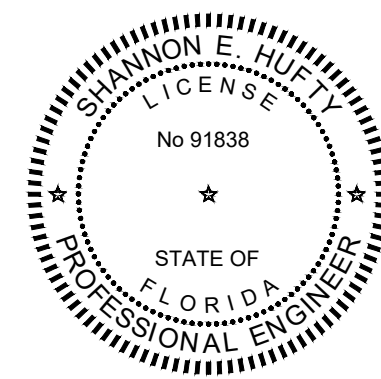

SHANNON E. HUFTY, PE
LICENSE NO.: 91838

SUBMITTAL:	ISSUE DATE:
100% CONSTRUCTION DOCUMENTS	08/24/2026

REVISION	DESCRIPTION	DATE
----------	-------------	------

**FLORIDA STATE
UNIVERSITY
ENERGY
RESEARCH
FACILITY**

FLORIDA STATE UNIVERSITY
2000 LEVY AVE, TALLAHASSEE,
FLORIDA 32310


KEY PLAN

DRAWING TITLE:

AUTOTURN EXHIBIT

PROJECT NO.:	26-5635	DRAWN BY:	
		CHECKED BY:	KRM

C 801

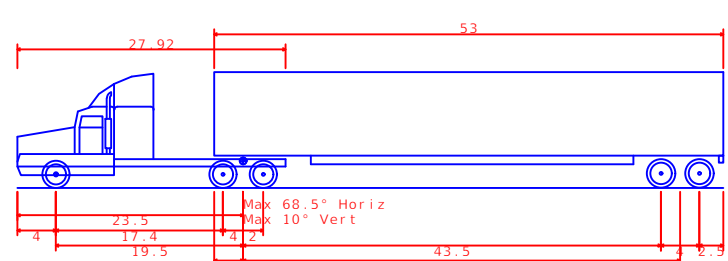

WB-67 - Interstate Semi-Trailer
Overall Length 73.500ft
Overall Width 8.500ft
Overall Body Height 12.02ft
Min Body Ground Clearance 3.34ft
Max Track Width 8.00ft
Lock-to-lock time 0.00ft
Curb to curb Turning Radius 45.000ft

FROM JUNE 2026 BUDGET - (600') 4" PIPE
- (16) 90s