# **SUPPLEMENT NO. 2**

### **COVER SHEET**

# Florida State University Bio Unit One – 2<sup>nd</sup> Floor Teaching Labs

# Bid Packages All Remaining

This supplement is a part of the contract documents.

This supplement consists of Item 1:

Item 1 - Addendum #1

End of Supplement Number 2 Dated this 28<sup>th</sup> of August 2025.





### Addendum 01

Project Manager

Childers Construction

Tallahassee, FL 32317

3472 Weems Road

**Date:** 08/25/2025 Project: FSU Bio Unit One, Teaching Labs

AD#: 01 Architect's Proj. No.: 23055

To: Wallis Walker, Owner: Mary Jo Spector, Director of Research

Facilities,

Design, Construction, and Maintenance

Florida State University

Mendenhall A 969 Learning Way Tallahassee, FL 32306

This Addendum is issued to the Bidders on the above referenced project to modify or interpret previously issued documents and is incorporated into the project Contract Documents.

**Description:** Revisions to CONSTRUCTION DOCUMENTS, dated 08/12/2025, as described below.

- AD-1.1. SPECIFICATION: 00 0110 / TABLE OF CONTENTS: Revise this section as follows:
  - a. Add DIVISION 11 EQUIPMENT section 11 5314 Fume Extractors to the TOC.
- AD-1.2. SPECIFICATION: 09 3000 / TILING: Revise this section as follows:
  - a. Revise grout color.
- AD-1.3. **SPECIFICATION: 11 5314 / FUME EXTRACTORS:** Add this specification section to the Contract Documents.
  - a. Added missing specification for proposed snorkels.
- AD-1.4. **DRAWING: A122 / LEVEL 2 PARTITION PLAN:** Replace this sheet in its entirety with the attached revised sheet.
  - **a.** Added and revised plan dimensions.
- AD-1.5. **DRAWING:** A132 / LEVEL 2 CEILING PLAN: Replace this sheet in its entirety with the attached revised sheet.
  - **a.** Adjusted ceiling layouts in all classrooms, the office break/conference area, the study/huddle area, and corridor 2000B. This revision may have altered the light fixture count in some rooms.
  - **b.** Changed the GWB soffits in Animal Diversity (2015) and Comparative Anatomy (2013) to the Axiom transition system and adjusted the grid to align with student table arrangement.
  - c. Changed the central ceiling height in Comparative Anatomy (2013) to 8'-8".
  - **d.** Added Axiom transition system to the south side of teaching lab (2007) and general biology (2011).
- AD-1.6. **DRAWING: A140 / ROOF PLAN:** Replace this sheet in its entirety with the attached revised sheet.
  - **a.** Relocate new steel framing to align with new fan position.





- AD-1.7. **DRAWING: A240 / ROOF DETAILS:** Replace this sheet in its entirety with the attached revised sheet.
  - **a.** Revised detail 2.
- AD-1.8. **DRAWING: S101 / GENERAL STRUCTURAL NOTES AND ROOF PLAN:** Replace this sheet in its entirety with the attached revised sheet.
  - a. Revised location of new steel framing.
  - **b.** Revised plan notes.
- AD-1.9. **DRAWING: S102 / SECTIONS AND DETAILS:** Replace this sheet in its entirety with the attached revised sheet.
  - a. Revised detail 3 notes.
  - **b.** Added new details 6 & 7.
- AD-1.10. **DRAWING: M102 / LEVEL 2 MECHANICAL DUCT PLAN**: Replace this sheet in its entirety with the attached revised sheet.
  - a. a. Diffusers and grilles realigned for updated RCP.
- AD-1.11. **DRAWING: M700 / AHU 2-1 MECHANICAL CONTROLS DIAGRAM**: Replace this sheet in its entirety with the attached revised sheet.
  - a. Relocated outside air damper downstream of energy recovery coil (ERC).
  - **b.** Identified fail positions for outside air and return air dampers.
  - c. Added fire alarm shutdown relay to VFD control points and associated keynote #3.
  - **d.** Clarified verbiage on keynote #1.
  - **e.** Clarified verbiage in control sequence relating to Cooling Coil Temperature Control and Cooling Coil Temperature Setpoint Reset Control.
  - **f.** Added setpoint column to controls pointlist table.
  - g. Added table note (4) to controls pointlist table.
- AD-1.12. **DRAWING: M800 / MECHANICAL DETAILS**: Replace this sheet in its entirety with the attached revised sheet.
  - a. Revised coil branch pipe sizes on Detail #2.
  - **b.** Removed strainer from Energy Recovery Coil Piping detail (Detail #4).
  - **c.** Replace swing valve with shut-off valve on In-Line Booster Pump detail (Detail #6).
- AD-1.13. **DRAWING: M801 / MECHANICAL DETAILS**: Replace this sheet in its entirety with the attached revised sheet.
  - **a.** Revised Roof Duct Supports detail (Detail #1) and added Vertical Fire Damper Installation detail (Detail #2).
  - b. Revised AHU 2-1 Component Detail (Detail #4).
  - **c.** Corrected LEF 2-1,2 Component Detail (Detail #5) to show combination roof curb.
  - d. Revised AHU 2-2 Component Detail (Detail #6).
  - **e.** Removed makeup line and associated accessories and detail keynote for Expansion Tank detail (Detail #8).
- AD-1.14. **DRAWING: M900 / MECHANICAL SCHEDULES:** Replace this sheet in its entirety with the attached revised sheet.
  - **a.** Revised scheduled performance values and/or modified schedule notes for the following schedules:
    - i. Semi-Custom Air Handling Units
    - ii. Return Fans
    - iii. Laboratory Exhaust Fans,
    - iv. Supply Air Terminal Devices





- v. Variable Volume Laboratory Air Terminals
- vi. Energy Recovery Coils
- vii. Energy Recovery Pump
- AD-1.15. **DRAWING: E102 / ELECTRICAL LIGHTING PLAN:** Replace this sheet in its entirety with the attached revised sheet.
  - a. Lighting realigned for updated RCP.
- AD-1.16. **DRAWING: E703 / FIRE ALARM RISER DIAGRAM, DETAILS, AND MATRIX:** Replace this sheet in its entirety with the attached revised sheet.
  - a. Removed Fire alarm smoke damper control detail.
- AD-1.17. **DRAWING: E900 / ELECTRICAL SCHEDULES:** Replace this sheet in its entirety with the attached revised sheet.
  - **a.** Changed LEF 2-2 CB to match design.
  - **b.** GEF 2-1 controls by div. 23.
  - c. Updated ERP 2-1 load per mechanical.

Best Regards,

Ken Lutz, RA Senior Architect



# SECTION 00 0110 TABLE OF CONTENTS

### PROCUREMENT AND CONTRACTING REQUIREMENTS

### 1.01 DIVISION 00 -- PROCUREMENT AND CONTRACTING REQUIREMENTS

- A. 00 0107 Seals
- B. 00 0110 Table of Contents
- C. 00 3100 Available Project Information

### **SPECIFICATIONS**

### 2.01 DIVISION 01 -- GENERAL REQUIREMENTS

- A. 01 1000 Summary
- B. 01 2000 Price and Payment Procedures
- C. 01 2500 Substitution Procedures
- D. 01 3000 Administrative Requirements
- E. 01 3100 Project Management and Coordination
- F. 01 3216 Construction Progress Schedule
- G. 01 3329.02 Sustainable Design Reporting LEED v4
- H. 01 3329.04 Material Content Form
- I. 01 3329.07 Prohibited Content Installer Certification
- J. 01 3566.05 Project Sustainability Goal Credit Summary LEED v4
- K. 01 3566.06 LEED Scorecard
- L. 01 3566.12 Sustainability Certification Project Procedures LEED v4
- M. 01 4000 Quality Requirements
- N. 01 4216 Definitions
- O. 01 5000 Temporary Facilities and Controls
- P. 01 6000 Product Requirements
- Q. 01 6116 Volatile Organic Compound (VOC) Content Restrictions
- R. 01 7000 Execution and Closeout Requirements
- S. 01 7419 Construction Waste Management and Disposal
- T. 01 7800 Closeout Submittals
- U. 01 7900 Demonstration and Training
- V. 01 9113 General Commissioning Requirements

### 2.02 DIVISION 02 -- EXISTING CONDITIONS

- A. 02 4100 Demolition
- 2.03 DIVISION 03 -- CONCRETE
- 2.04 DIVISION 04 -- MASONRY
- 2.05 DIVISION 05 -- METALS
  - A. 05 5000 Metal Fabrications

### 2.06 DIVISION 06 -- WOOD, PLASTICS, AND COMPOSITES

- A. 06 1000 Rough Carpentry
- B. 06 4100 Architectural Wood Casework

### 2.07 DIVISION 07 -- THERMAL AND MOISTURE PROTECTION

- A. 07 0553 Fire and Smoke Assembly Identification
- B. 07 2119 Foamed-In-Place Insulation
- C. 07 5360 Patching Existing Roof System
- D. 07 6200 Sheet Metal Flashing and Trim
- E. 07 7000 Fastener Schedule
- F. 07 8400 Firestopping
- G. 07 9200 Joint Sealants

### 2.08 DIVISION 08 -- OPENINGS

- A. 08 1113 Hollow Metal Doors and Frames
- B. 08 1416 Flush Wood Doors
- C. 08 3100 Access Doors and Panels
- D. 08 4313 Aluminum-Framed Storefronts
- E. 08 7100 Door Hardware
- F. 08 8000 Glazing
- G. 08 8300 Mirrors
- H. 08 8813 Fire-Rated Glazing
- I. 08 9100 Louvers

### 2.09 DIVISION 09 -- FINISHES

- A. 09 2116 Gypsum Board Assemblies
- B. 09 2216 Non-Structural Metal Framing
- C. 09 3000 Tiling
- D. 09 5100 Acoustical Ceilings
- E. 09 6500 Resilient Flooring
- F. 09 6813 Tile Carpeting
- G. 09 9123 Interior Painting

### 2.10 DIVISION 10 -- SPECIALTIES

- A. 10 1100 Visual Display Units
- B. 10 2113.19 Plastic Toilet Compartments
- C. 10 2600 Wall and Door Protection
- D. 10 2800 Toilet, Bath, and Laundry Accessories
- E. 10 4400 Fire Protection Specialties

### 2.11 DIVISION 11 -- EQUIPMENT

A. 11 5314 - Fume Extractors

### 2.12 DIVISION 12 -- FURNISHINGS

- A. 12 3553.13 Metal Laboratory Casework
- B. 12 3553.19 Wood Laboratory Casework
- C. 12 3600 Countertops

### 2.13 DIVISION 13 -- SPECIAL CONSTRUCTION

### 2.14 DIVISION 14 -- CONVEYING EQUIPMENT

### 2.15 DIVISION 21 -- FIRE SUPPRESSION

A. 21 1314 - Automatic Fire Sprinkler System

### 2.16 DIVISION 22 -- PLUMBING

- A. 22 0529 Plumbing Piping and Equipment Supporting Devices
- B. 22 0553 Plumbing Systems Identification
- C. 22 0700 Plumbing Systems Insulation
- D. 22 1118 Water Distribution System
- E. 22 1314 Sanitary Waste and Storm Drainage Systems
- F. 22 2114 Plumbing Specialties
- G. 22 4000 Plumbing Fixtures
- H. 22 6114 Laboratory Compressed Air System
- I. 22 6653 Corrosion Resistant Waste and Vent System
- J. 22 6714.13 Plastic Piping for High Purity Service

### 2.17 DIVISION 23 -- HEATING, VENTILATING, AND AIR-CONDITIONING (HVAC)

- A. 23 0000 General Mechanical Requirements
- B. 23 0513 Motors for Mechanical Equipment
- C. 23 0514 Variable Frequency Drive (VFD) System
- D. 23 0529 Mechanical Piping and Equipment Supporting Devices
- E. 23 0550 Vibration Isolation
- F. 23 0553 Mechanical Systems Identification
- G. 23 0594A Water Systems Test Adjust Balance
- H. 23 0595 Air Systems Test Adjust Balance
- I. 23 0700 Mechanical Systems Insulation
- J. 23 0901 Control Systems Integration
- K. 23 2116 Pipe and Pipe Fittings
- L. 23 2118 Valves
- M. 23 2120 Piping Specialties
- N. 23 2123 Pumps
- O. 23 2514 Chemical Treatment Systems
- P. 23 3114 Ductwork
- Q. 23 3314 Ductwork Specialties
- R. 23 3400 Fans
- S. 23 3713 Diffusers, Registers and Grilles
- T. 23 4114 Filters
- U. 23 7328 Factory Fabricated Custom Air Handling Units
- V. 23 8214 Heating and Cooling Terminal Devices
- W. 23 8216 Coils

### 2.18 DIVISION 25 -- INTEGRATED AUTOMATION

### 2.19 DIVISION 26 -- ELECTRICAL

A. 26 0000 - General Electrical Requirements

- B. 26 0516 Owner-Furnished Equipment
- C. 26 0519 Low- Voltage Electrical Power Conductors and Cables
- D. 26 0526 Grounding and Bonding for Electrical Systems
- E. 26 0529 Hangers and Supports for Electrical Systems
- F. 26 0533 Raceway and Boxes for Electrical Systems
- G. 26 0533.13 Surface Raceway System
- H. 26 0553 Electrical Systems Identification
- 26 0593 Electrical Systems Firestopping
- J. 26 0800 Commissioning of Electrical Systems
- K. 26 0923 Lighting Control Devices
- L. 26 0933.19 Architectural Dimming System
- M. 26 2416.13 Lighting and Appliance Panelboards
- N. 26 2726 Wiring Devices
- O. 26 4113 Lightning Protection for Structures
- P. 26 5000 Lighting
- 2.20 DIVISION 27 -- COMMUNICATIONS
- 2.21 DIVISION 28 -- ELECTRONIC SAFETY AND SECURITY
  - A. 28 3113 Fire Detection and Alarm Systems
- 2.22 DIVISION 31 -- EARTHWORK
- 2.23 DIVISION 32 -- EXTERIOR IMPROVEMENTS
- 2.24 DIVISION 33 -- UTILITIES
- 2.25 DIVISION 46 -- WATER AND WASTEWATER EQUIPMENT

**END OF SECTION** 

### SECTION 09 3000 TILING

### **PART 1 GENERAL**

### 1.01 SECTION INCLUDES

- Tile for floor applications.
- B. Tile for wall applications.
- C. Cementitious backer board as tile substrate.
- D. Non-ceramic trim.

### 1.02 RELATED REQUIREMENTS

A. Section 07 9200 - Joint Sealants: Sealing joints between tile work and adjacent construction and fixtures.

### 1.03 REFERENCE STANDARDS

- A. ANSI A108.1a American National Standard Specifications for Installation of Ceramic Tile in the Wet-Set Method, with Portland Cement Mortar; 2017.
- B. ANSI A108.1b Installation of Ceramic Tile on a Cured Portland Cement Mortar Setting Bed with Dry-Set, Modified Dry-Set, or Improved Modified Dry-Set Cement Mortar; 2023.
- C. ANSI A108.1c Contractor's Option: Installation of Ceramic Tile in the Wet-Set Method with Portland Cement Mortar or Installation of Ceramic Tile on a Cured Portland Cement Mortar Setting Bed with Dry-Set, Modified Dry-Set, or Improved Modified Dry-Set Cement Mortar; 2023.
- D. ANSI A108.2 American National Standard General Requirements: Materials, Environmental and Workmanship; 2019.
- E. ANSI A108.4 American National Standard Specifications for Installation of Ceramic Tile with Organic Adhesive or Water Cleanable Tile-Setting Epoxy Adhesive; 2023.
- F. ANSI A108.5 Setting of Ceramic Tile with Dry-Set Cement Mortar, Modified Dry-Set Cement Mortar, EGP (Exterior Glue Plywood) Modified Dry-Set Cement Mortar, or Improved Modified Dry-Set Cement Mortar; 2023.
- G. ANSI A108.6 American National Standard Specifications for Installation of Ceramic Tile with Chemical Resistant, Water Cleanable Tile-Setting and -Grout Epoxy; 2023.
- H. ANSI A108.8 American National Standard Specifications for Installation of Ceramic Tile with Chemical Resistant Furan Resin Mortar and Grout; 1999 (Reaffirmed 2024).
- I. ANSI A108.9 American National Standard Specifications for Installation of Ceramic Tile with Modified Epoxy Emulsion Mortar/Grout; 2023.
- J. ANSI A108.10 American National Standard Specifications for Installation of Grout in Tilework; 2017 (Reaffirmed 2022).
- K. ANSI A108.11 American National Standard Specifications for Interior Installation of Cementitious Backer Units; 2018.
- ANSI A108.12 Installation of Ceramic Tile with EGP (Exterior Glue Plywood) Modified Dry-Set Mortar; 2023.
- M. ANSI A108.13 American National Standard for Installation of Load Bearing, Bonded, Waterproof Membranes for Thin-Set Ceramic Tile and Dimension Stone; 2005 (Reaffirmed 2021).
- N. ANSI A108.19 American National Standard Specifications for Interior Installation of Gauged Porcelain Tiles and Gauged Porcelain Tile Panels/Slabs by the Thin-Bed Method Bonded with Modified Dry-Set Cement Mortar or Improved Modified Dry-Set Cement Mortar; 2020.

- O. ANSI A108.20 American National Standard Specifications for Exterior Installation of Gauged Porcelain Tiles and Gauged Porcelain Tile Panels/Slabs; 2020.
- P. ANSI A118.3 American National Standard Specifications for Chemical Resistant, Water Cleanable Tile-Setting and -Grouting Epoxy and Water Cleanable Tile-Setting Epoxy Adhesive; 2021.
- Q. ANSI A118.4 American National Standard Specifications for Modified Dry-Set Cement Mortar; 2019.
- R. ANSI A118.9 American National Standard Specifications for Test Methods and Specifications for Cementitious Backer Units; 2019.
- S. ANSI A118.10 American National Standard Specifications for Load Bearing, Bonded, Waterproof Membranes for Thin-Set Ceramic Tile and Dimension Stone; 2014 (Reaffirmed 2019).
- T. ANSI A118.12 American National Standard Specifications for Crack Isolation Membranes for Thin-Set Ceramic Tile and Dimension Stone Installation; 2014 (Reaffirmed 2019).
- U. ANSI A118.15 American National Standard Specifications for Improved Modified Dry-Set Cement Mortar; 2019.
- V. ANSI A137.1 American National Standard Specifications for Ceramic Tile; 2022.
- W. ASTM F710 Standard Practice for Preparing Concrete Floors to Receive Resilient Flooring; 2021.
- X. ASTM F2170 Standard Test Method for Determining Relative Humidity in Concrete Floor Slabs Using in situ Probes; 2019a.
- Y. TCNA (HB) Handbook for Ceramic, Glass, and Stone Tile Installation; 2021.

### 1.04 ADMINISTRATIVE REQUIREMENTS

A. Preinstallation Meeting: Convene a preinstallation meeting one week before starting work of this section; require attendance by affected installers.

### 1.05 SUBMITTALS

- A. See Section 01 3000 Administrative Requirements for submittal procedures.
- B. Product Data: Provide manufacturers' data sheets on tile, mortar, grout, trim, and accessories. Include instructions for using grouts and adhesives.
- C. Sustainable Design Submittals:
  - 1. Environmental Product Declaration (EPD): For each product.
  - 2. Health Product Declaration: For each product.
  - 3. Product Data: Provide manufacturer's data sheets on adhesives indicating VOC content.
  - 4. Laboratory Test Reports: Indicate compliance with requirements for low-emitting materials, including adhesives and sealers.
- D. Shop Drawings: Indicate tile layout, patterns, junctions with dissimilar materials, control, contraction, isolation and expansion joints, setting details, and non-ceramic trim locations.
- E. Samples for Verification:
  - 1. Minimum 6 by 6 inch sample of each type and composition of tile for each color and finish required.
- F. Maintenance Data: Include recommended cleaning methods, cleaning materials, and stain removal methods.
- G. Maintenance Materials: Furnish the following for Owner's use in maintenance of project.
  - 1. See Section 01 6000 Product Requirements, for additional provisions.
  - 2. Extra Tile: 1 percent of each size, color, and surface finish combination.
  - 3. Extra Grout: 3 percent of amount installed for each type, composition and color indicated.

### 1.06 QUALITY ASSURANCE

- A. Manufacturer Qualifications: Company specializing in manufacturing the types of products specified in this section, with minimum five years of documented experience.
  - 1. Source Limitations for Tile: Obtain tile of each type and color or finish from single source or producer.
    - a. Obtain tile of each type and color or finish from same production run and of consistent quality in appearance and physical properties for each contiguous area.
  - 2. Source Limitations for Setting and Grouting Materials: Obtain ingredients of a uniform quality for each mortar, adhesive, and grout component from single manufacturer and each aggregate from single source or producer.
    - a. Obtain setting and grouting materials, except for unmodified Portland cement and aggregate, from single manufacturer.
    - b. Obtain waterproof membrane and crack isolation membrane, except for sheet products, from manufacturer of setting and grouting materials.
  - 3. Source Limitations for Other Products: Obtain each of the following products specified in this Section from a single manufacturer:
    - a. Cementitious backer units.
    - b. Metal edge strips.

### B. Installer Qualifications:

- 1. Company specializing in performing tile installation, with minimum of five years of documented experience.
- 2. Accredited Five-Star member of the National Tile Contractors Association (NTCA) or Trowel of Excellence member of the Tile Contractors' Association of America (TCAA).
- Installer Certification:
  - a. Ceramic Tile Education Foundation (CTEF): Certified Tile Installer (CTI).
  - b. Apprenticeship Program: Installer has achieved Journeyworker status through an apprenticeship from the International Union of Bricklayers and Allied Craftworkers (IUBAC) or a U.S. Department of Labor (DOL)-recognized program.
  - c. Advanced Certifications for Tile Installers (ACT): Certification in the installation of membranes, mortar bed (mud) floors, mortar (mud) walls, shower receptors, large format tile, and grouts.
  - d. International Masonry Training and Education Foundation (IMTEF): Supervisor Certification Program (SCP).

### 1.07 DELIVERY, STORAGE, AND HANDLING

- A. Deliver and store packaged materials in original containers with seals unbroken and labels intact until time of use. Comply with requirements in ANSI A137.1 for labeling tile packages.
- B. Store tile and cementitious materials on elevated platforms, under cover, and in a dry location.
- C. Store tile and cementitious materials on elevated platforms, under cover, and in a dry location.
- D. Protect adhesives from freezing or overheating in accordance with manufacturer's instructions.

### 1.08 FIELD CONDITIONS

- A. Do not install solvent-based products in an unventilated environment.
- B. Maintain ambient and substrate temperature above 50 degrees F and below 100 degrees F during installation and curing of setting materials.

### **PART 2 PRODUCTS**

### 2.01 TILE

- A. Manufacturers: All products of each type by the same manufacturer.
  - 1. Substitutions: See Section 01 6000 Product Requirements.
- B. Glazed Wall Tile, Type T1: ANSI A137.1 standard grade.
  - Manufacturer: Garden State Tile

- 2. Product: Uptown
- 3. Size: 4 by 16 inch, nominal.
- 4. Surface Finish: Matte glaze.
  - Color: Vintage Grey.
- 5. Pattern: as indicated in Drawings.
- 6. Bond Coat Type: Latex-Portland Cement.
- 7. Grout Color: Mapei, 5077 Frost
- 8. Grout Joint: 1/8"
- C. Glazed Wall Tile, Type T3: ANSI A137.1 standard grade.
  - 1. Manufacturer: Garden State Tile
  - Product: Outfit Hexagon
  - 3. Size: 6 by 7, nominal.
  - 4. Surface Finish: High gloss.
    - Color: Smoke.
  - 5. Bond Coat Type: Latex-Portland Cement.
  - 6. Grout Color: Mapei, 5103 Cobblestone
  - 7. Grout Joint: 1/8"
- D. Quarry Tile, Type T4: ANSI A137.1 standard grade.
  - 1. Manufacturer: Metropolitan Ceramics
  - Product: Quarry Basics
  - 3. Size: 8 by 8 inch, nominal.
  - 4. Surface Finish: Unglazed.
  - 5. Color(s): 710 Raven.
  - 6. Pattern: Grid.
  - 7. Bond Coat Type: Latex-Portland Cement.
  - 8. Grout Color:
  - 9. Grout Joint: 1/8"
  - 10. Trim Units: Matching cove base shapes in sizes coordinated with field tile.
- E. Porcelain Tile, Type T2: ANSI A137.1 standard grade.
  - 1. Manufacturer: Garden State Tile
  - 2. Product: Bestow
  - 3. Size: 24 by 48 inch, nominal.
  - 4. Surface Finish: Textured.
  - 5. Color(s): Arku Warm Gray.
  - 6. Installation Pattern: As indicated in Drawings.
  - 7. Bond Coat Type: Improved Latex-Portland Cement.
  - 8. Grout Color: [Mapei, 5027 Silver]Mapei, 5107 Iron
  - 9. Grout Joint: 1/8"
  - 10. Trim Units: Matching bullnose shapes in sizes coordinated with field tile.

### 2.02 TRIM AND ACCESSORIES

- A. Non-Ceramic Trim: Brushed stainless steel, style and dimensions to suit application, for setting using tile mortar or adhesive.
  - 1. Applications:
    - a. Open edges of wall tile.
      - 1) Product: Schluter Jolly Profile
      - 2) Accessories: Outside Corner
      - 3) Material and Finish: Stainless Steel Type 304
    - b. Wall corners, outside-:
      - 1) Product: Schluter Jolly Profile
      - 2) Accessories: Outside Corner
      - 3) Material and Finish: Stainless Steel Type 304

- c. Transition between floor finishes:
  - Product: Schluter Reno-U
  - 2) Material and Finish: Stainless Steel Type 304
- 2. Manufacturers:
  - a. Schluter-Systems: www.schluter.com/#sle.
  - b. Substitutions: See Section 01 6000 Product Requirements.

### 2.03 SETTING MATERIALS

- A. Latex-Portland Cement Mortar Bond Coat: ANSI A118.4.
  - Products:
    - a. Mapei; Ultraflex 1
    - b. Substitutions: See Section 01 6000 Product Requirements.
- B. Improved Latex-Portland Cement Mortar Bond Coat: ANSI A118.15.
  - Products:
    - a. Mapei; Ultraflex 3
    - b. Substitutions: See Section 01 6000 Product Requirements.

### **2.04 GROUTS**

- A. Manufacturers:
  - 1. Mapei
  - 2. Substitutions: See Section 01 6000 Product Requirements.
- B. Epoxy Grout: ANSI A118.3 chemical resistant and water-cleanable epoxy grout
  - 1. Applications: Floor and Typical floor and floor wall base, unless otherwise indicated.
  - Color(s): As indicated.
  - 3. Products:
    - a. Mapei, Kerapoxy CQ
    - b. Substitutions: See Section 01 6000 Product Requirements.

### 2.05 ACCESSORY MATERIALS

- A. Waterproofing and Crack Isolation Membrane: Specifically designed for bonding to cementitious substrate under thick mortar bed or thin-set tile; complying with ANSI A118.10.
  - 1. Crack Resistance: No failure at 1/16 inch gap, minimum; comply with ANSI A118.12.
  - 2. Fluid or Trowel Applied Type:
    - a. Material: Synthetic rubber or Acrylic.
    - b. Thickness: 25 mils, minimum, dry film thickness.
    - c. Products:
      - 1) Mapei: Mapelastic AquaDefense
      - 2) ARDEX Engineered Cements; ARDEX 8+9: www.ardexamericas.com/#sle.
      - 3) H.B. Fuller Construction Products, Inc; TEC HydraFlex Waterproofing Crack Isolation Membrane: www.tecspecialty.com/#sle.
      - 4) LATICRETE International, Inc; LATICRETE HYDRO BAN: www.laticrete.com/#sle.
      - 5) Merkrete, by Parex USA, Inc; Merkrete Hydro Guard 1: www.merkrete.com/#sle.
      - 6) Substitutions: See Section 01 6000 Product Requirements.
- B. Backer Board: Cementitious type complying with ANSI A118.9; high density, glass fiber reinforced, 5/8" inch thick; 2 inch wide coated glass fiber tape for joints and corners.
  - 1. Products:
    - a. Durock
    - b. Substitutions: See Section 01 6000 Product Requirements.

09 3000 - 5

### **PART 3 EXECUTION**

### 3.01 EXAMINATION

- A. Verify that subfloor surfaces are smooth and flat within the tolerances specified for that type of work and are ready to receive tile.
- B. Verify that wall surfaces are smooth and flat within the tolerances specified for that type of work, are dust-free, and are ready to receive tile.
- C. Verify that subfloor surfaces are dust free and free of substances that could impair bonding of setting materials to subfloor surfaces.
- D. Verify that joints and cracks in tile substrates are coordinated with tile joint locations; if not coordinated, adjust joint locations in consultation with Architect.
- E. Cementitious Subfloor Surfaces: Verify that substrates are ready for tiling installation by testing for moisture and alkalinity (pH).
  - Test as Follows:
    - a. Alkalinity (pH): ASTM F710.
    - b. Internal Relative Humidity: ASTM F2170.
  - 2. Obtain instructions if test results are not within limits recommended by tiling material manufacturer and setting material manufacturer.
  - 3. Follow moisture and alkalinity remediation procedures in Section 09 0561.
- F. Verify that required floor-mounted utilities are in correct location.

### 3.02 PREPARATION

- A. Protect surrounding work from damage.
- B. Vacuum clean surfaces and damp clean.
- C. Seal substrate surface cracks with filler. Level existing substrate surfaces to acceptable flatness tolerances.
- D. Install backer board in accordance with ANSI A108.11 and board manufacturer's instructions. Tape joints and corners, cover with skim coat of setting material to a feather edge.
- E. Prepare substrate surfaces for adhesive installation in accordance with adhesive manufacturer's instructions.

### 3.03 INSTALLATION - GENERAL

- A. Install tile and grout in accordance with applicable requirements of ANSI A108.1a through ANSI A108.19, manufacturer's instructions, and TCNA (HB) recommendations.
- B. Lay tile to pattern indicated. Do not interrupt tile pattern through openings.
- C. Cut and fit tile to penetrations through tile, leaving sealant joint space. Form corners and bases neatly. Align floor joints.
- D. Place tile joints uniform in width, subject to variance in tolerance allowed in tile size. Make grout joints without voids, cracks, excess mortar or excess grout, or too little grout.
- E. Form internal angles square and external angles bullnosed.
- F. Install non-ceramic trim in accordance with manufacturer's instructions.
- G. Install thresholds where indicated.
- H. Sound tile after setting. Replace hollow sounding units.
- I. Keep control and expansion joints free of mortar, grout, and adhesive.
- J. Prior to grouting, allow installation to completely cure; minimum of 48 hours.
- K. Grout tile joints unless otherwise indicated. Use standard grout unless otherwise indicated.
- L. At changes in plane and tile-to-tile control joints, use tile sealant instead of grout, with either bond breaker tape or backer rod as appropriate to prevent three-sided bonding.

### 3.04 INSTALLATION - FLOORS - THIN-SET METHODS

- A. Over interior concrete substrates, install in accordance with TCNA (HB) Method F113, dry-set or latex-Portland cement bond coat, with grout indicated.
  - 1. Where waterproofing membrane is indicated, install in accordance with TCNA (HB) Method F122, with latex-Portland cement grout.
- B. Install tile-to-tile floor movement joints in accordance with TCNA (HB) Method EJ171F.

### 3.05 INSTALLATION - WALL TILE

- A. Over cementitious backer units on studs, install in accordance with TCNA (HB) Method W244, using membrane at toilet rooms.
- B. Over interior concrete and masonry install in accordance with TCNA (HB) Method W202, thinset with dry-set or latex-Portland cement bond coat.

 
### 3.06 CLEANING

A. Clean tile and grout surfaces.

### 3.07 PROTECTION

- A. Do not permit traffic over finished floor surface for 4 days after installation.
- B. Protect installed tile work with kraft paper or other heavy covering during construction period to prevent staining, damage, and wear.
  - 1. If recommended by tile manufacturer, apply coat of neutral protective cleaner to completed tile walls and floors.
- C. Before final inspection, remove protective coverings and rinse neutral protective cleaner from tile surfaces.

### **END OF SECTION**



### SECTION 11 5314 FUME EXTRACTORS

### **PART 1 GENERAL**

### 1.01 SECTION INCLUDES

A. Fume extractors.

### 1.02 RELATED REQUIREMENTS

A. Section 05 5000 - Metal Fabrications: Above-ceiling supports and/or bracing.

### 1.03 REFERENCE STANDARDS

- A. AAMA 611 Voluntary Specification for Anodized Architectural Aluminum; 2020.
- B. ANSI Z9.5 Laboratory Ventilation; 2022.
- C. ASTM A276/A276M Standard Specification for Stainless Steel Bars and Shapes; 2017.
- D. ASTM B221 Standard Specification for Aluminum and Aluminum-Alloy Extruded Bars, Rods, Wire, Profiles, and Tubes; 2021.
- E. ASTM B221M Standard Specification for Aluminum and Aluminum-Alloy Extruded Bars, Rods, Wire, Profiles, and Tubes (Metric); 2021.
- F. ASTM D5857 Standard Specification for Polypropylene Injection and Extrusion Materials Using ISO Protocol and Methodology; 2017.
- G. ASTM F593 Standard Specification for Stainless Steel Bolts, Hex Cap Screws, and Studs; 2017.

### 1.04 ADMINISTRATIVE REQUIREMENTS

- A. Coordination: Coordinate the installation of fume extractors with laboratory casework and general lab exhaust system.
- B. Preinstallation Meeting: Conduct a preinstallation meeting one week prior to the start of the work of this section; require attendance by all affected installers.
- C. Sequencing: Ensure that utility connections are achieved in an orderly and expeditious manner.

### 1.05 SUBMITTALS

- A. See Section 01 3000 Administrative Requirements, for submittal procedures.
- B. Product Data: Fume extractor(s) dimensions and construction, utility and service requirements and locations, reach range diagrams.
- C. Shop Drawings: Indicate locations, large scale plans, elevations, cross sections, rough-in dimensions and tolerances, clearances required, locations and types of mounting accessories.
- D. Manufacturer's Certificate: Certify that products meet or exceed specified requirements.
- E. Manufacturer's Installation Instructions: Indicate special installation requirements.
- F. Operation Data: Include description of fume extractor(s) operation and required adjusting and testing.
- G. Maintenance Data: Identify system maintenance requirements, servicing cycles, lubrication types required and local spare part sources.
- H. Warranty Documentation: Submit manufacturer warranty and ensure that forms have been completed in Owner's name and registered with manufacturer.

### 1.06 QUALITY ASSURANCE

A. Manufacturer Qualifications: Company specializing in manufacturing products specified in this section, with not less than three years of documented experience.

B. Installer Qualifications: Company specializing in performing work of the type specified and with minimum three years of documented experience.

### 1.07 DELIVERY, STORAGE, AND HANDLING

A. Protect finished surfaces during handling and installation with protective covering of polyethylene film or another suitable material.

### 1.08 FIELD CONDITIONS

A. Ambient Conditions: Maintain temperature and relative humidity at occupancy levels during and after installation of fume extractors.

### 1.09 WARRANTY

- A. See Section 01 7800 Closeout Submittals, for additional warranty requirements.
- B. Correct defective Work within a five year period after Date of Substantial Completion.
- C. Provide two-year manufacturer warranty for manufacturer's standard items (listed by part number in manufacturer's official publication).

### **PART 2 PRODUCTS**

### 2.01 MANUFACTURERS

- A. Alsident System A/S www.alsident.com/#sle.
- B. Nederman www.nederman.com/#sle.
- C. Plymovent www.plymovent.com/#sle.
- D. MoveX www.movexinc.com.
- E. Substitutions: See Section 01 6000 Product Requirements.

### 2.02 MANUFACTURED UNITS

- A. Basis of Design Manufacturer: MoveX ME STD.
- B. Fume Extraction Arms General: Local exhaust ventilation device connected to facility air exhaust system.
  - Extraction systems consisting of:
    - a. Multiple articulated rigid arms connected with rotating joints.
    - b. Fume collection hood.
    - c. Mounting connectors and brackets.
  - 2. System capable of 360 degrees rotation at joints, with a damper at one of the joints, and thumbscrews for fixing the angle of each arm.
  - 3. Fume Extraction Arm:
    - a. Application: Common fumes, no requirements for anti-static or increased chemical resistance.
    - b. System Diameter: 2.95 inches.
    - c. Exhaust Capacity (Optimal Airflow Range): 65-140 CFM.
    - d. Maximum Noise: Noise at maximum airflow: 57 dB(A).
    - e. Maximum Fume Temperature: 158 degrees F.
    - f. Main System: Three-arms.
      - 1) Ceiling Connector: Manufacturer's standard, for ceiling mounting.
      - 2) Ceiling Connector Joint: White.
      - 3) Upper Arm: Aluminum tube.
      - 4) Middle Connector Joint: White.
      - 5) Lower Arm: Aluminum tube.
      - 6) Joint with Damper: White.
      - 7) Damper Handle: Manufacturer's standard (if provided).
      - 8) Collection Hood Arm: Aluminum tube.
      - 9) Collection Hood: Round, aluminum, with anodized finish.

- (a) Size: Round, 7 7/8 inch diameter.
- 10) Thumbscrews: Knurled head, diameter coordinated with hole in elbow.
- g. Accessory components:
  - Ceiling Mounting Bracket: Manufacturer's standard mounting bracket for attaching fume extraction assembly to structure.
  - 2) Extension Column/Arm: Manufacturer's standard extension.
  - 3) Ceiling Cover Plate: Manufacturer's standard cover plate for use at ceiling penetration opening for Extension Column/Arm.
  - 4) Support Collar/Bracket: Manufacturer's standard Collar/Bracket for bracing Upper Arm of system.
  - 5) Ductwork Reducer Kit: Manufacturer's standard reducer, sized as required to connect fume extraction system to building's exhaust air duct.
  - 6) Airflow Alarm: Manufacturer's standard audible and visual alarm, with adjustable airflow velocity alarm setpoint.

### 2.03 MATERIALS

- A. Extruded Aluminum: ASTM B221 ASTM B221M.
  - Finish: Class I Natural Anodized Finish: AAMA 611 AA-M12C22A41 clear anodic coating not less than 0.7 mils thick.
- B. Polypropylene: ASTM D5857.
  - 1. Polyethylene Terephthalate Glycol (PETG): Transparent, thermo-formed.
- C. Stainless Steel:
  - 1. Stainless Steel Bars, Shapes and Moldings: ASTM A276/A276M, Type 316L.
  - 2. Stainless Steel (bolts and thumbscrews): ASTM F593, Group 2 316L Alloy.

### PART 3 EXECUTION

### 3.01 EXAMINATION

- A. Examine areas, with Installer present, for compliance with requirements for installation tolerances and other conditions affecting performance of fume extractors.
- B. Coordinate locations with laboratory casework. Confirm installed fume extractor will allow opening doors, and access to contents, of adjacent wall (upper) cabinets.
- C. Proceed with installation only after unsatisfactory conditions have been corrected.

### 3.02 INSTALLATION

- A. Install in accordance with manufacturer's instructions and shop drawings.
- B. Interface With Other Work: Interface with installation of above-ceiling supports and/or bracing, ceilings, laboratory casework, and other types of laboratory ventilation equipment and systems.
- C. Systems Integration: Integrate fume extractors into overall exhaust system installation, including controls.

### 3.03 ADJUSTING

A. Adjust moving parts for smooth, near silent, operation with one hand.

### 3.04 CLEANING

- A. See Section 01 7419 Construction Waste Management and Disposal, for additional requirements.
- B. Clean finished surfaces, touch up as required; and remove or refinish damaged or soiled areas to match original factory finish, as approved by Architect.

### 3.05 CLOSEOUT ACTIVITIES


- A. See Section 01 7800 Closeout Submittals, for closeout submittals.
- B. See Section 01 7900 Demonstration and Training, for additional requirements.
- C. Final Acceptance:

- 1. Remove labels, fingerprints, and clean all surfaces both inside and out.
- 2. Repair any marred or damaged surfaces that affect appearance, such as both interior and exterior of extractors in a manner acceptable to Owner.
- 3. Replace any parts that cannot be repaired in such a manner.
- D. Demonstration: Demonstrate operation of fume extractors to Owner's personnel.
  - 1. Use operation and maintenance data as reference during demonstration.
  - 2. Briefly describe function, operation, and maintenance of each component.

### 3.06 PROTECTION

A. Protect installed local fume extractors from subsequent construction operations.

### **END OF SECTION**

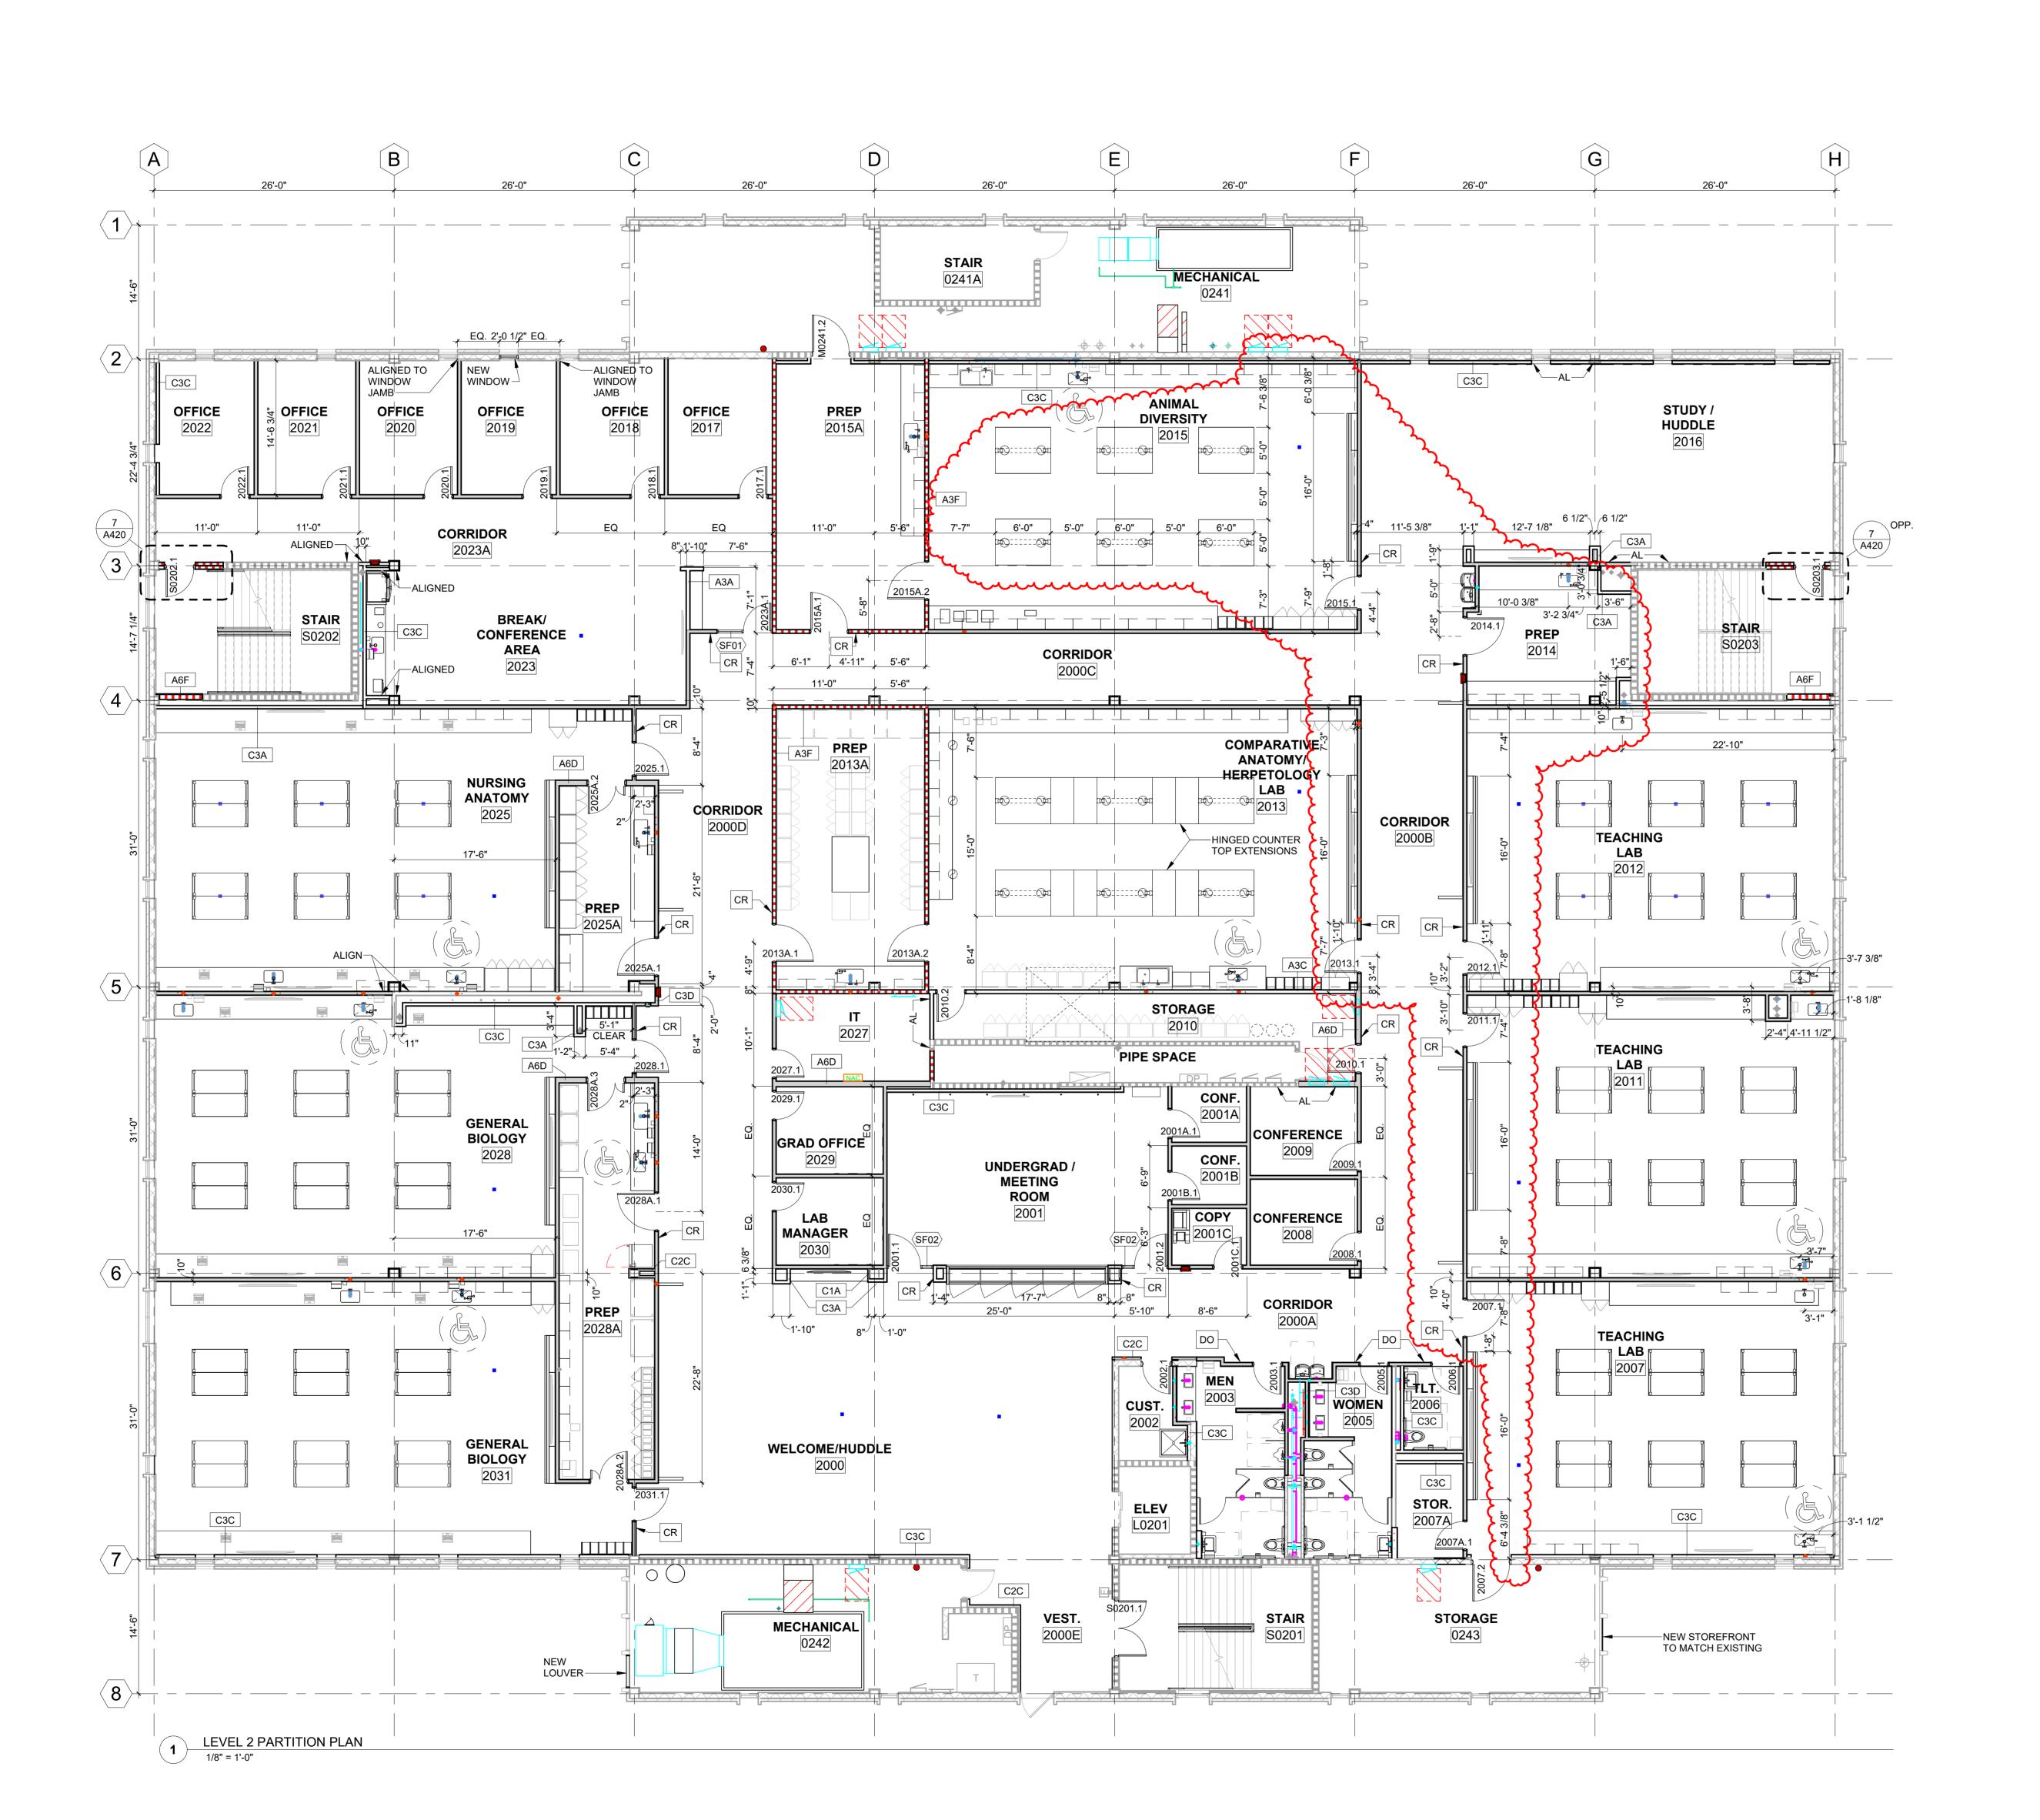

# PARTITION PLAN SHEET NOTES

- 1. SEE WALL SECTIONS FOR EXTERIOR WALL ASSEMBLY INFORMATION. 2. SEE SHEET A152 FOR FLOOR SLAB PENETRATION COORDINATION. 3. SEE SHEET A400 FOR PARTITION TYPES AND DETAILS. 4. INTERIOR PARTITIONS ARE TYPE A3D UNLESS OTHERWISE INDICATED.
- 5. PROVIDE HEADERS TO STRUCTURE ABOVE AT INTERIOR STOREFRONT PARTITIONS. 6. PROVIDE IN WALL BACKING FOR WALL MOUNTED ITEMS. 7. PARTITIONS NOT DIMENSIONED ARE GENERALLY LOCATED BY ONE OF
- THE FOLLOWING CRITERIA: A. CENTERLINE - CENTER OF PARTITION ALIGNS WITH A STRUCTURAL GRIDLINE OR OBJECT CENTERLINE (SUCH AS WINDOW MULLION OR B. ALIGN - LOCATE PARTITION FLUSH WITH FACE OF GYPSUM BOARD OR
- OTHER SURFACE INDICATED C. MAINTAIN DIMENSIONS NOTED AS "MINIMUM" OR "CLEAR" 8. WHERE DOORS ARE LOCATED IN THE CORNER OF A ROOM WITHOUT A
- DIMENSION, PROVIDE 5" OF CLEARANCE TO ROUGH OPENING. 9. PROVIDE MINIMUM 1'-0" CLEAR AT PUSH SIDES OF DOORS AND 1'-6" CLEAR AT PULL SIDES OF DOORS UNLESS INDICATED OTHERWISE.
- 10. MOUNT SINKS AND LAVATORIES WITH A MINIMUM OF 1'-3" FROM THE CENTERLINE OF THE FIXTURE TO THE FINISH SURFACE OF ADJACENT
- 11. WALL PRIORITY: WHERE RATED PARTITIONS INTERSECT OTHER RATED PARTITIONS OR UNRATED PARTITIONS, CONSTRUCT HIGHER RATED PARTITION CONTINUOUS AND ABUT THE LOWER RATED OR UNRATED PARTITION TO THE HIGHER RATED PARTITION.
- 12. MAINTAIN FIRE RATING INDICATED FOR EXISTING PARTITIONS. 13. WHERE NEW PARTITIONS EXTEND OR ABUT EXISTING PARTITIONS, ALIGN THE FINISH FACE OF THE NEW PARTITION WITH THE EXISTING PARTITION AND PROVIDE A TRANSITION WITHOUT VISIBLE SEAMS OR JOINTS.
- 14. PROVIDE COMMUNICATIONS ROOM BOARD ON ALL WALLS OF IT 2027. SEE 06 1000. 3/4" THICK AC GRADE PLYWOOD, 8' X 4' PANELS TRIMMED TO FIT WALL LENGTH. MOUNT WITH BOTTOM OF PANEL AT TOP OF WALL BASE. TOP OF PANEL AT 8'-4". INSTALL SMOOTH SIDE OUT. THE PLYWOOD SHALL BE VOID FREE AND PAINTED FRONT, BACK, AND EDGES PRIOR TO INSTALLATION. MOUNT ON TOP OF GYPSUM BOARD, NOT IN LIEU OF GYPSUM BOARD.

**ARCHITECT** WALKER ARCHITECTS

> GAINESVILLE, FL 32609 352.672.6448 AA26002009

2035 NW 13TH STREET

**MEPF ENGINEER** AFFILIATED ENGINEERS 12921 SW 1 ROAD, #205

NEWBERRY, FL 32669 352.376.5500

STRUCTURAL ENGINEER WALTER P. MOORE 201 E KENNEDY BLVD #700 TAMPA FL 33602 813.221.2424

SEAL AND SIGNATURE

TIMOTHY JAMES WILLIAMS, AIA LICENSE NO.: AR94953

CONSTRUCTION DOCUMENTS 08/12/2025 08/25/2025 ADDENDUM-01


# **FSU BIO UNIT** ONE TEACHING **LABS**

FLORIDA STATE UNIVERSITY, 89 CHIEFTAN WAY, TALLAHASSEE, FL 32306



LEVEL 2 PARTITION PLAN

PROJECT NO.: 23055-00 DRAWN BY: CHECKED BY: JMO

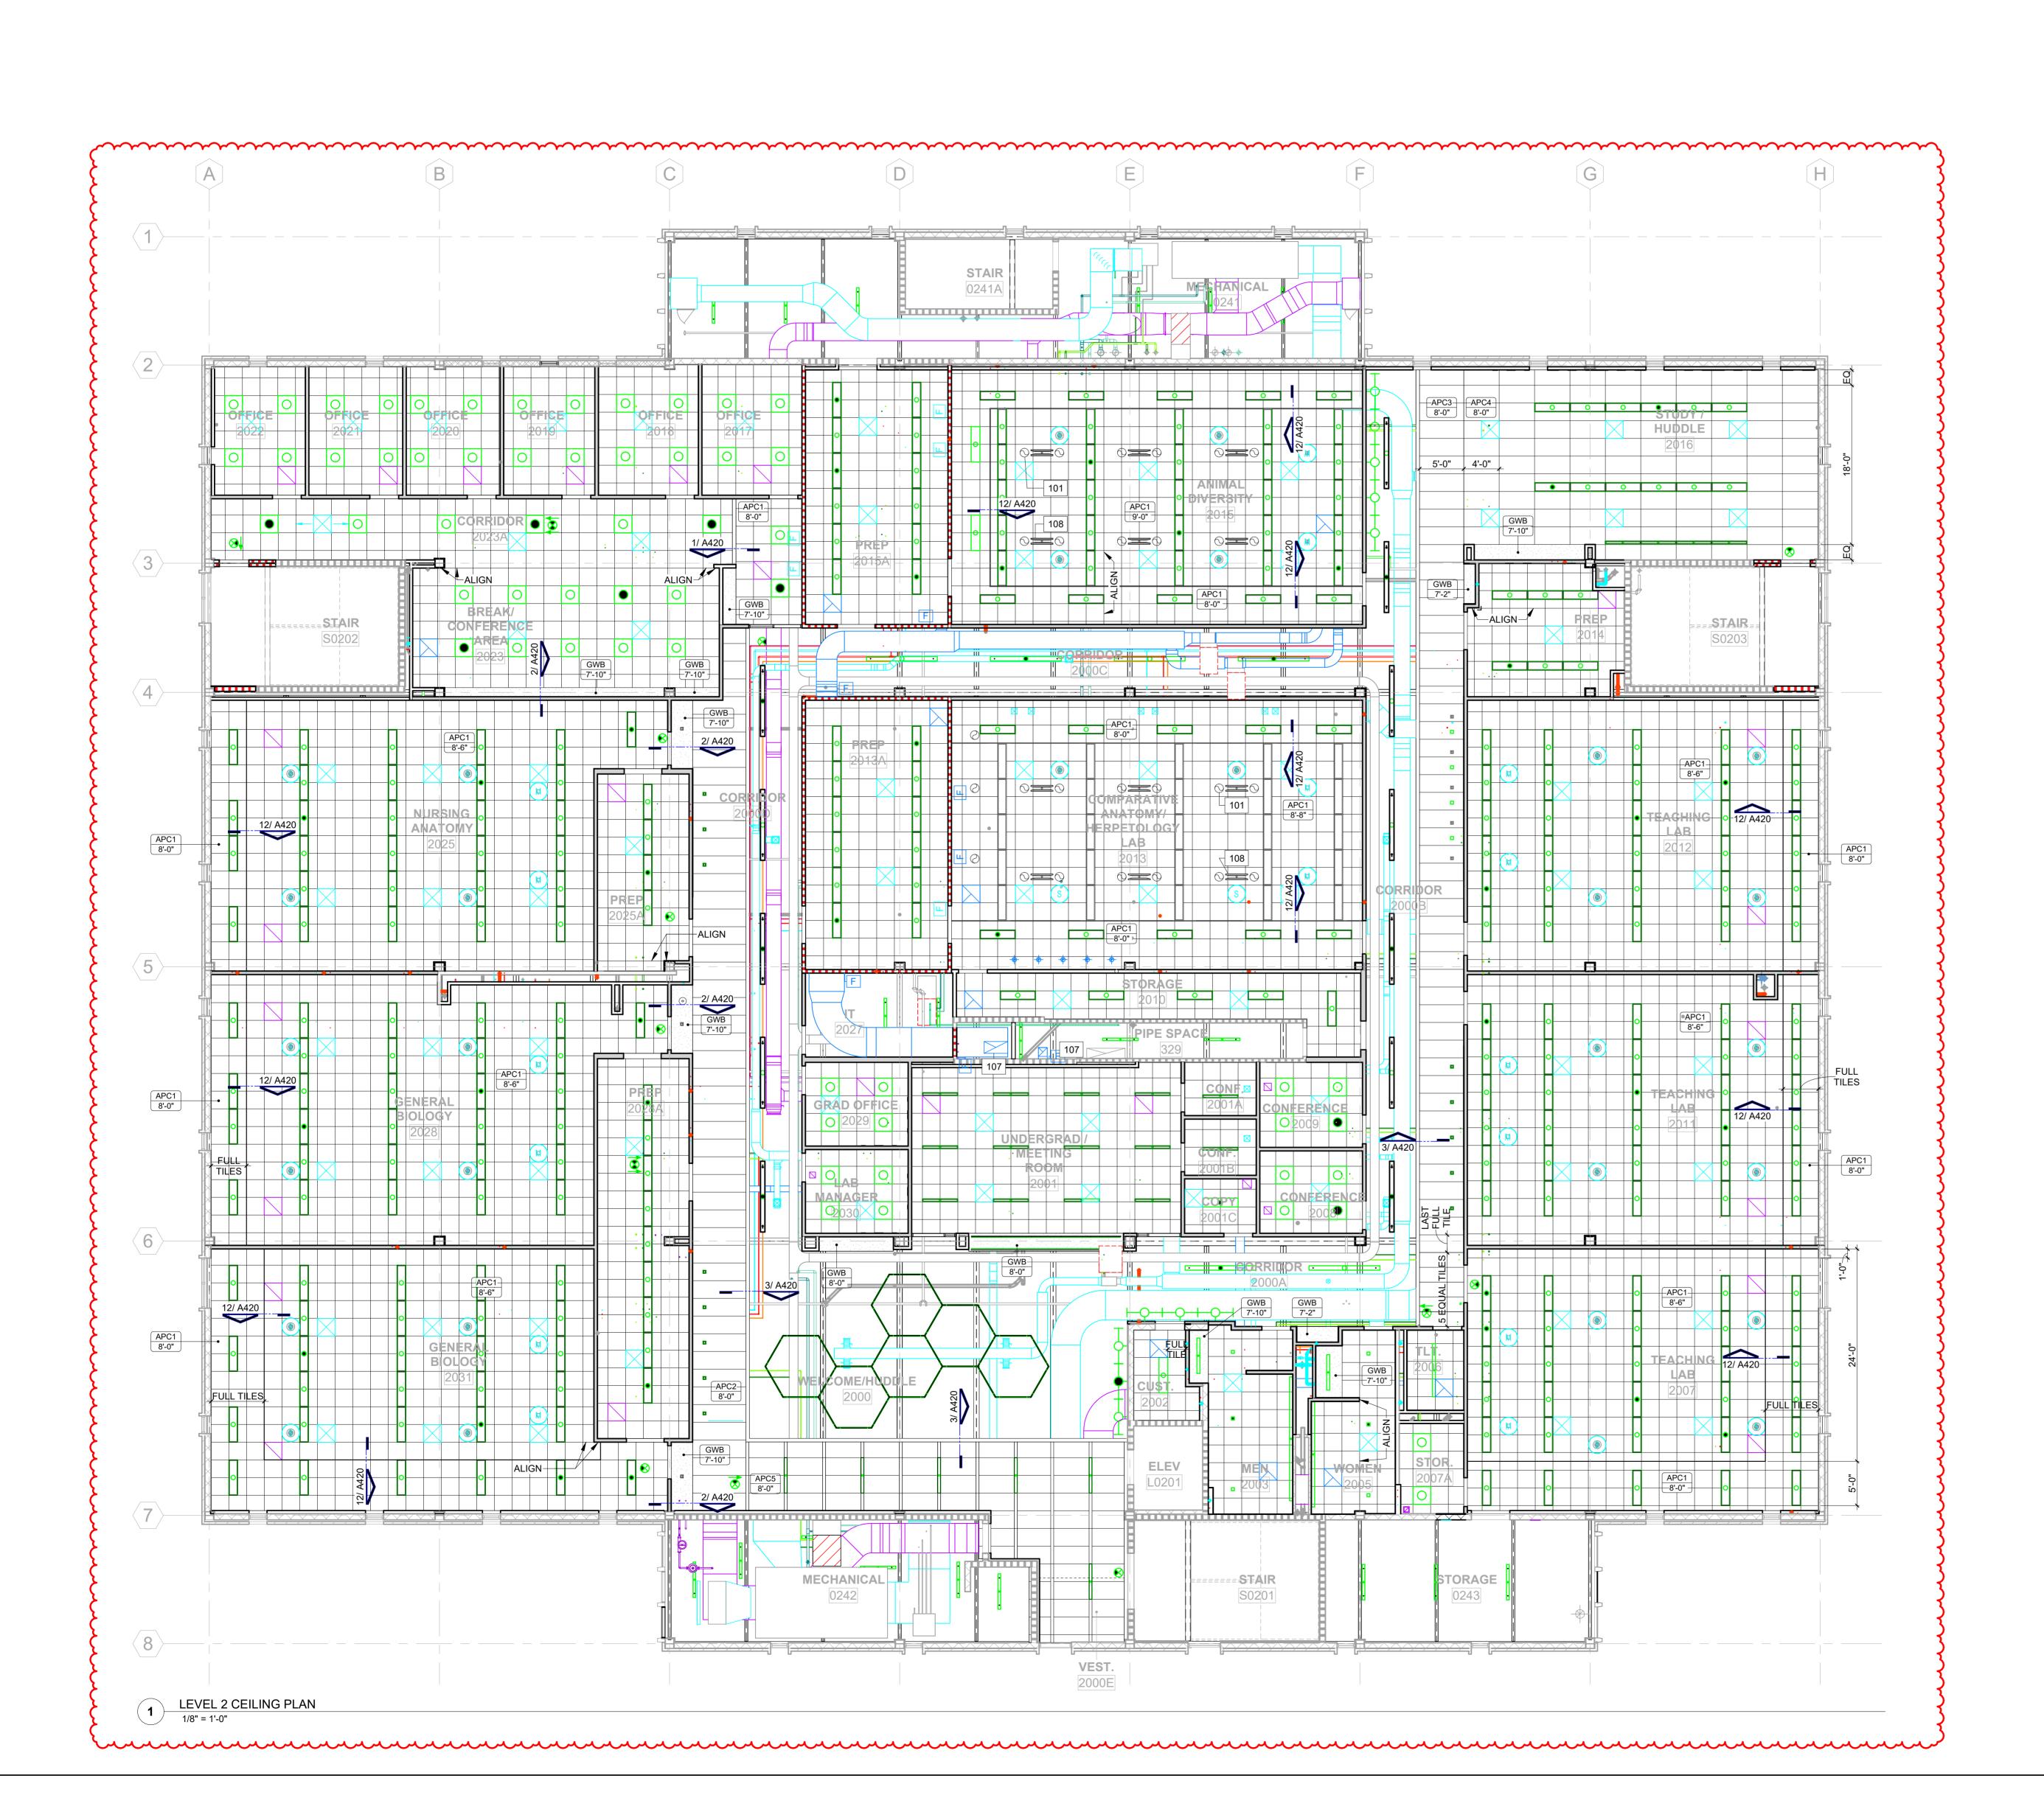

# CEILING PLAN SHEET NOTES

- CEILING ELEMENTS (LIGHTS, GRILLS, ETC...) SHOWN FOR LOCATION AND COORDINATION.
- COORDINATE LOCATION, SIZE, AND REQUIREMENTS OF CEILING ELEMENTS WITH M/E/P/F DOCUMENTS.
   SUSPENDED TILE CEILING GRIDS SHALL BE SET WITH EITHER A FULL TILE OR A GRID INTERSECTION OCCURRING AT THE CENTER OF THE CEILING EXPANSE SO AS TO ACHIEVE TILES OF EQUAL WIDTH AT OPPOSING SIDES OF THE CEILING. NO CEILING GRID CONFIGURATION SHALL RESULT IN A TILE AT ANY PERIMETER
- EDGE OF LESS THAN 4 INCHES IN WIDTH.

  4. IMMEDIATELY BRING DISCREPANCIES TO THE ARCHITECT'S ATTENTION.


  5. IN ACCUSTICAL PANEL CELLINGS, CENTER CELLING ELEMENTS IN PANELS.
- IN ACOUSTICAL PANEL CEILINGS, CENTER CEILING ELEMENTS IN PANELS.
   IN GYPSUM WALL BOARD CEILINGS ALIGN CEILING ELEMENTS WITH ADJACENT
- CEILING ELEMENTS.

  7. PROVIDE ACCESS PANELS IN NON-ACCESSIBLE CEILINGS (SUCH AS GYPSUM BOARD) WHERE REQUIRED FOR ACCESS TO SERVICEABLE MECHANICAL, ELECTRICAL, OR PLUMBING DEVICES. PROVIDE COORDINATED ACCESS PANEL
- LOCATION SHOP DRAWING FOR REVIEW AND APPROVAL BY ARCHITECT PRIOR TO INSTALLATION.

  8. ACOUSTIC PANEL CEILINGS ARE APC1 AND 8'-0" AFF UNLESS OTHERWISE

# **CEILING LEGEND**

INDICATED.

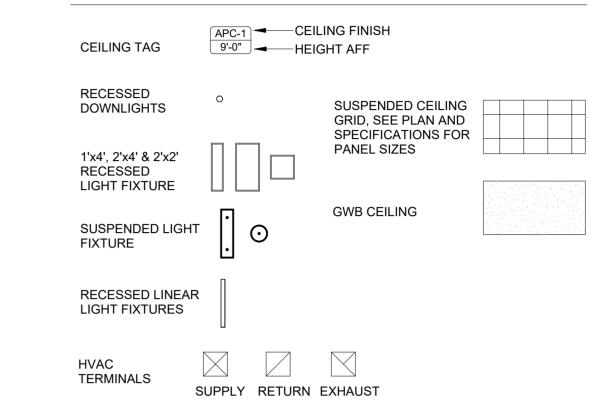

# **KEYNOTE LEGEND**

- SNORKEL ARM MOUNTED TO STRUCTURE ABOVE. SEE DETAIL 6/A420.
  COORDINATE NEW DUCT TO ALIGN WITH EXISTING ROOF CURB.
- 8 BACK-TO-BACK SUSPENDED MONITORS ON POST MOUNTED TO STRUCTURE ABOVE. MONITOR BRACKETS ARE O.F.C.I.

# Walker Architect

ARCHITECT

WALKER ARCHITECTS
2035 NW 13TH STREET
GAINESVILLE, FL 32609

MEPF ENGINEER

AFFILIATED ENGINEERS 12921 SW 1 ROAD, #205 NEWBERRY, FL 32669 352.376.5500

352.672.6448 AA26002009

STRUCTURAL ENGINEER

WALTER P. MOORE 201 E KENNEDY BLVD #700 TAMPA FL 33602 813.221.2424

SEAL AND SIGNATURE

TIMOTHY JAMES WILLIAMS, AIA LICENSE NO.: AR94953

SUBMITTAL:ISSUE DATE:CONSTRUCTION DOCUMENTS08/12/2025REVISIONDESCRIPTIONDATE2ADDENDUM-0108/25/2025

# FSU BIO UNIT ONE TEACHING LABS

FLORIDA STATE UNIVERSITY 89 CHIEFTAN WAY, TALLAHASSEE, FL 32306

KEY PLAN



LEVEL 2 CEILING PLAN

 PROJECT NO.:
 23055-00
 DRAWN BY:
 JM

 CHECKED BY:
 JMO

A132



# **ROOF PLAN SHEET NOTES**

 COORDINATE ALL EQUIPMENT SHOWN ON THE ROOF PLAN WITH CONSTRUCTION DOCUMENTS ASSOCIATED WITH THEIR RESPECTIVE DISCIPLINES.

# **KEYNOTE LEGEND**

- 103 REMOVE EXISTING CURB CAP; FABRICATE NEW CURB CAP TO ACCOMODATE NEW DUCT AND FAN; SEE MECHANICAL.
- ACCOMODATE NEW DUCT AND FAN; SEE MECHANICAL.

  104 PROVIDE ADDITIONAL STEEL FRAMING TO SUPPORT NEW EQUIPMENT;
  SEE MECHANICAL AND STRUCTURAL SHEETS.
- 106 BLOCK SUPPORT FOR PIPES.

Walker Architect

ARCHITECT

WALKER ARCHITECTS
2035 NW 13TH STREET
GAINESVILLE, FL 32609
352.672.6448 AA26002009

MEPF ENGINEER

AFFILIATED ENGINEERS 12921 SW 1 ROAD, #205 NEWBERRY, FL 32669 352.376.5500

STRUCTURAL ENGINEER

WALTER P. MOORE 201 E KENNEDY BLVD #700 TAMPA FL 33602 813.221.2424

SEAL AND SIGNATURE

TIMOTHY JAMES WILLIAMS, AIA LICENSE NO.: AR94953

SUBMITTAL: ISSUE DATE:

CONSTRUCTION DOCUMENTS 08/12/2025

REVISION DESCRIPTION DATE

2 ADDENDUM-01 08/25/2025

FSU BIO UNIT
ONE TEACHING
LABS

FLORIDA STATE UNIVERSITY, 89 CHIEFTAN WAY, TALLAHASSEE, FL 32306

KEY PLAN



ROOF PLAN

PROJECT NO.: 23055-00 DRAWN BY: AH
CHECKED BY: JMO

A140

NOW SHOP-PARRICATED 22 GALDE
3/MANLESS STITLE CORD COP
(SLOWE TO TRANS)

EXISTING TERRIBATION SAR.

EXISTING SOCIENT TO DRAINE

SOCIENT TO DRAINE SEE STEPL


SOCIENT TO DRAINE

NEW SOCIENT TO DRAINE SEE STEPL

SOCIENT TO DRAINE SEE STEPLE

SO

DUCT PENETRATION
3" = 1'-0"

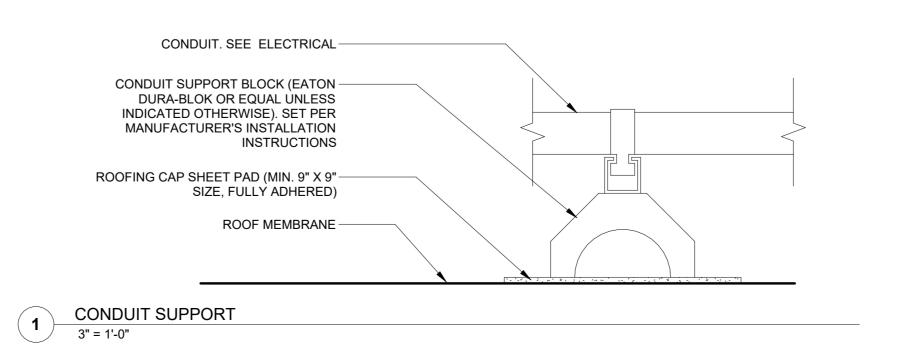

Walker Architects

ARCHITECT

WALKER ARCHITECTS
2035 NW 13TH STREET
GAINESVILLE, FL 32609
352.672.6448 AA26002009

MEPF ENGINEER

AFFILIATED ENGINEERS
12921 SW 1 ROAD, #205
NEWBERRY, FL 32669
352.376.5500

WALTER P. MOORE 201 E KENNEDY BLVD #700 TAMPA FL 33602 813.221.2424

SEAL AND SIGNATURE

TIMOTHY JAMES WILLIAMS, AIA LICENSE NO.: AR94953

SUBMITTAL:ISSUE DATE:CONSTRUCTION DOCUMENTS08/12/2025REVISIONDESCRIPTIONDATE2ADDENDUM-0108/25/2025

FSU BIO UNIT
ONE TEACHING
LABS

FLORIDA STATE UNIVERSITY, 89 CHIEFTAN WAY, TALLAHASSEE, FL 32306

KEY PLAN

DRAWING TITLE:

ROOF DETAILS

PROJECT NO.: 23055-00 DRAWN BY: KAL
CHECKED BY: TW

**A240** 

# GENERAL STRUCTURAL NOTES

# PART I - DESIGN CRITERIA

- GENERAL BUILDING CODE
- THE CONTRACT DOCUMENTS ARE BASED ON THE REQUIREMENTS OF THE FLORIDA BUILDING CODE - 8TH EDITION (2023).

## . WIND LOADS

- 1. WIND PRESSURES ARE BASED ON THE PROVISIONS OF THE FLORIDA BUILDING CODE WHICH REFER TO THE AMERICAN SOCIETY OF CIVIL ENGINEERS, MINIMUM DESIGN LOADS FOR BUILDINGS AND OTHER STRUCTURES, ASCE 7-22 AND THE FOLLOWING CRITERIA:
- a. ULTIMATE DESIGN WIND SPEED (VULT): 135 MPH (3 SECOND GUST) b. NOMINAL DESIGN WIND SPEED (VASD): 105 MPH (3-SECOND GUST) c. BUILDING RISK CATEGORY: III d. WIND EXPOSURE CATEGORY: B

# PART II - STRUCTURAL STEEL

# . MATERIAL

- 1. HOT ROLLED STRUCTURAL MEMBERS. ALL HOT ROLLED STEEL PLATES, SHAPES, SHEET PILING, AND BARS SHALL BE NEW STEEL CONFORMING TO ASTM SPECIFICATION A6.
- 2. ASTM SPECIFICATION AND GRADE. CLEARLY MARK THE GRADE OF STEEL ON EACH PIECE, WITH A DISTINGUISHING MARK VISIBLE FROM FLOOR SURFACES, FOR THE PURPOSE OF FIELD INSPECTION OF PROPER GRADE OF STEEL. UNLESS NOTED OTHERWISE ON THE DRAWINGS, STRUCTURAL STEEL SHALL
- BE AS FOLLOWS: a. RECTANGULAR HSS: ASTM A 500, GRADE C (FY=50 KSI) b. L-SHAPES. ALL L-SHAPES SHALL CONFORM TO ASTM A36 UNLESS

NOTED OTHERWISE ON THE DRAWINGS.

- 1) ALL CONNECTION MATERIAL, EXCEPT AS NOTED OTHERWISE HEREIN OR ON THE DRAWINGS, INCLUDING BEARING PLATES, GUSSET PLATES. STIFFENER PLATES. FILLER PLATES. ANGLES. ETC. SHALL CONFORM TO ASTM A36 UNLESS A HIGHER GRADE OF STEEL IS REQUIRED BY STRENGTH AND PROVIDED THE RESULTING SIZES ARE COMPATIBLE WITH THE CONNECTED MEMBERS.
- B. STRUCTURAL BOLTS AND THREADED FASTENERS
- 1. A325 BOLTS. ALL BOLTS IN STRUCTURAL CONNECTIONS SHALL CONFORM TO ASTM A325 TYPE 1, UNLESS INDICATED OTHERWISE ON THE DRAWINGS.
- WELDING
  - 1. UNLESS NOTED OTHERWISE, ELECTRODES FOR WELDING SHALL CONFORM TO E70XX (SMAW), F7XX-EXXX (SAW), ER70S-X (GMAW), OR E7XT-X (FCAW).

# PART III - CONCRETE MASONRY

# A. SCOPE

- 1. REFER TO ARCHITECT'S DRAWINGS FOR THE EXTENT OF MASONRY WALLS. NON-LOADBEARING WALLS MAY NOT BE SHOWN ON THE STRUCTURAL DRAWINGS.
- PROVIDE ONE-COURSE HORIZONTAL BOND BEAM REINFORCE WITH 1-#5 CONTINUOUS AT EVERY FLOOR LEVEL, ROOF LEVEL, AND PARAPET, MINIMUM

### CONCRETE MASONRY UNITS.

- 1. CONCRETE STRENGTH OF MASONRY UNITS (BASED ON NET AREA) SHALL BE 1,900 PSI MINIMUM.
- 2. UNITS SHALL CONFORM TO ASTM C 55 OR ASTM C 90 AND SAMPLED IN ACCORDANCE WITH ASTM C 140.

# MORTAR

1. USE ONLY PORTLAND CEMENT/LIME, TYPE M OR S, MORTAR CONFORMING TO ASTM C 270. PROVIDE AN AVERAGE COMPRESSIVE STRENGTH AT 28 DAYS OF 1,800

# GROUT

- 1. MIX DESIGNS: a. FOR FILLING SPACES 4" OR LARGER IN BOTH DIRECTIONS, USE "COARSE GROUT" WITH A MINIMUM COMPRESSIVE STRENGTH OF 3,000 PSI. THE GROUT SHALL BE TESTED IN ACCORDANCE WITH ASTM C1019. FOR FILLING SPACES LESS THAN 4" IN ONE OR BOTH HORIZONTAL DIRECTIONS, USE "FINE GROUT"
- b. USE 3,000 PSI NORMALWEIGHT CONCRETE FOR FILLING SPACES 10" AND LARGER IN BOTH DIRECTIONS. THE GROUT SHALL BE TESTED IN ACCORDANCE WITH ASTM C 1019.
- c. ALL GROUT MIX DESIGN SUBMITTALS SHALL INCLUDE THE RESULTS OF
- THE TESTS PERFORMED IN ACCORDANCE WITH ASTM C 1019. d. SLUMP RANGE AT POINT OF FINAL DISCHARGE: 8" TO 11". e. THE USE OF AIR ENTRAINING ADMIXTURES IS NOT ALLOWED.

# MINIMUM REINFORCEMENT FOR CONCRETE MASONRY UNITS

PROPORTIONED PER ASTM C 476.

- REINFORCING STEEL IN CONCRETE MASONRY CONSTRUCTION: ASTM A 615, GRADE 60.
- 2. PROVIDE VERTICAL REINFORCEMENT IN CELLS OF CONCRETE MASONRY UNITS (FULLY EMBEDDED IN GROUT) AS SHOWN ON THE PLANS AND OTHER DETAILS. MINIMUM REINFORCEMENT OF INTERIOR AND EXTERIOR MASONRY SHALL BE AS FOLLOWS:
- a. 1-#5 AT A MAXIMUM SPACING OF 48 INCHES b. 1-#5 AT EACH CORNER
- c. 1-#5 AT EACH SIDE OF OPENINGS UP TO 12 FEET WIDE
- 3. MINIMUM LAP OF ALL REINFORCING STEEL SHALL BE AS FOLLOWS: a. #5: 30 INCHES

# DO NOT LAP VERTICAL REINFORCEMENT AT INTERSECTING BOND BEAMS.

- REINFORCEMENT SHALL BE CONTINUOUS THROUGH INTERSECTING BOND BEAMS.
- 4. TERMINATION OF REINFORCING STEEL: a. ALL VERTICAL REINFORCEMENT SHALL HAVE STANDARD HOOK INTO BOND BEAM OR TIE BEAM. TERMINATE AT HIGHEST BOND BEAM IF MASONRY DOES NOT EXTEND TO ROOF OR GROUTED CELL IS NOT CONTINUOUS TO ROOF. HOOK SHALL EXTEND TO THE UPPERMOST HORIZONTAL REINFORCEMENT OF THE BOND BEAM AND
- HAVE A MINIMUM EMBEDMENT OF 6". b. ALL HORIZONTAL REINFORCEMENT AT ENDS OF BOND BEAMS SHALL HAVE STANDARD HOOK INTO VERTICAL GROUTED CELL. PROVIDE CORNER BARS SUCH

THAT HORIZONTAL REINFORCEMENT IS CONTINUOUS AROUND CORNERS.

# REINFORCING STEEL COVERAGE

- 1. COVER TO REINFORCING STEEL WITHIN MASONRY ELEMENTS SHALL NOT BE LESS THAN THE FOLLOWING: a. EXPOSED TO EARTH OR WEATHER: 2" (#6 AND LARGER BARS), 1.5"
- (#5 AND SMALLER BARS). b. NOT EXPOSED TO EARTH OR WEATHER: 1.5"
- c. LONGITUDINAL WIRES OF JOINT REINFORCEMENT SHALL BE FULLY EMBEDDED IN MORTAR OR GROUT WITH A MINIMUM COVER OF 5/8" WHEN EXPOSED TO EARTH AND WEATHER AND 1/2" WHEN NOT EXPOSED TO EARTH OR WEATHER.

# PART IV - SUBMITTALS

- SHOP DRAWINGS
- 1. THE GENERAL CONTRACTOR SHALL SUBMIT FOR ENGINEER REVIEW SHOP DRAWINGS FOR THE FOLLOWING ITEMS: a. STRUCTURAL STEEL, SHOP AND ERECTION DRAWINGS (S&S) b. DELEGATED CANOPY SHOP DRAWINGS AND CONNECTIONS (S&s).

# REPRODUCTION

THE USE OF ELECTRONIC FILES OR REPRODUCTIONS OF THESE CONTRACT DOCUMENTS BY ANY CONTRACTOR, SUBCONTRACTOR, ERECTOR, FABRICATOR, OR MATERIAL SUPPLIER IN LIEU OF PREPARATION OF SHOP DRAWINGS SIGNIFIES THEIR ACCEPTANCE OF ALL INFORMATION SHOWN HEREON AS CORRECT, AND OBLIGATES THEMSELVES TO ANY JOB EXPENSE, REAL OR IMPLIED, ARISING DUE TO ANY ERRORS THAT MAY OCCUR HEREON.

# PART V - MISCELLANEOUS

# CONTRACT DOCUMENTS

- 1. IT IS THE RESPONSIBILITY OF THE GENERAL CONTRACTOR TO OBTAIN ALL CONTRACT DOCUMENTS AND LATEST ADDENDA AND TO SUBMIT SUCH DOCUMENTS TO ALL SUBCONTRACTORS AND MATERIAL SUPPLIERS PRIOR TO THE SUBMITTAL OF SHOP DRAWINGS, FABRICATION OF ANY STRUCTURAL MEMBERS,
- AND ERECTION IN THE FIELD. 2. THE CONTRACT STRUCTURAL DRAWINGS AND SPECIFICATIONS REPRESENT THE FINISHED STRUCTURE, AND, EXCEPT WHERE SPECIFICALLY SHOWN, DO NOT INDICATE THE METHOD OR MEANS OF CONSTRUCTION. THE CONTRACTOR SHALL SUPERVISE AND DIRECT THE WORK AND SHALL BE SOLELY RESPONSIBLE FOR ALL
- CONSTRUCTION MEANS, METHODS, PROCEDURES, TECHNIQUES, AND SEQUENCE. WHERE MEMBER LOCATIONS ARE NOT SPECIFICALLY DIMENSIONED. MEMBERS ARE EITHER LOCATED ON COLUMNS LINES OR ARE EQUALLY SPACED BETWEEN LOCATED MEMBERS.

### B. DRAWING CONFLICTS

THE GENERAL CONTRACTOR SHALL COMPARE THE ARCHITECTURAL AND STRUCTURAL DRAWINGS AND REPORT ANY DISCREPANCY BETWEEN EACH SET OF DRAWINGS AND WITHIN EACH SET OF DRAWINGS TO THE ARCHITECT AND ENGINEER PRIOR TO THE FABRICATION AND INSTALLATION OF ANY STRUCTURAL MEMBERS.

CONFLICTS IN STRUCTURAL REQUIREMENTS

WHERE CONFLICT EXISTS AMONG THE VARIOUS PARTS OF THE STRUCTURAL CONTRACT DOCUMENTS, STRUCTURAL DRAWINGS, GENERAL NOTES, AND SPECIFICATIONS. THE STRICTEST REQUIREMENTS, AS INDICATED BY THE ENGINEER, SHALL GOVERN.

## EXISTING CONDITIONS

- 1. THE GENERAL CONTRACTOR SHALL VERIFY ALL DIMENSIONS AND CONDITIONS OF THE EXISTING BUILDING AT THE JOB SITE AND REPORT ANY DISCREPANCIES FROM ASSUMED CONDITIONS SHOWN ON THE DRAWINGS TO THE ARCHITECT AND ENGINEER PRIOR TO THE FABRICATION AND ERECTION OF ANY
- EXISTING CONSTRUCTION SHOWN ON THE DRAWINGS WAS OBTAINED FROM EXISTING CONSTRUCTION DOCUMENTS . THESE DRAWINGS OF EXISTING CONSTRUCTION ARE AVAILABLE FOR CONTRACTOR USE. HOWEVER, THE AVAILABLE DRAWINGS OF EXISTING CONSTRUCTION ARE NOT NECESSARILY COMPLETE. THE CONTRACTOR SHALL FIELD VERIFY ALL PERTINENT
- DEMOLITION, CUTTING, DRILLING, ETC. OF EXISTING WORK SHALL BE PERFORMED WITH GREAT CARE SO AS NOT TO JEOPARDIZE THE STRUCTURAL INTEGRITY OF THE EXISTING BUILDING. IF ANY ARCHITECTURAL, STRUCTURAL, OR MEP MEMBERS NOT DESIGNATED FOR REMOVAL INTERFERE WITH THE NEW WORK, THE ARCHITECT SHALL BE NOTIFIED IMMEDIATELY AND APPROVAL OBTAINED PRIOR TO REMOVAL OF THOSE MEMBERS.
- 4. THE CONTRACTOR SHALL REPAIR ALL DAMAGE CAUSED DURING CONSTRUCTION WITH SIMILAR MATERIALS AND WORKMANSHIP TO RESTORE CONDITIONS TO LEVELS ACCEPTABLE TO THE ARCHITECT.

# RESPONSIBILITY OF THE CONTRACTOR FOR CONSTRUCTION LOADS

THE STRUCTURE HAS BEEN DESIGNED FOR THE LOADS IDENTIFIED WITHIN THESE STRUCTURAL DRAWINGS THAT ARE ANTICIPATED TO BE APPLIED TO THE FINAL STRUCTURE ONCE COMPLETED AND OCCUPIED. THE CONTRACTOR SHALL NOT OVERLOAD THE STRUCTURE DURING CONSTRUCTION. THE CONTRACTOR SHALL BE RESPONSIBLE FOR CHECKING THE ADEQUACY OF THE STRUCTURE TO SUPPORT ANY APPLIED CONSTRUCTION LOADS, INCLUDING THOSE DUE TO CONSTRUCTION VEHICLES OR EQUIPMENT, MATERIAL HANDLING OR STORAGE, SHORING OR RESHORING, OR ANY OTHER CONSTRUCTION ACTIVITY. THE CONTRACTOR SHALL SUBMIT CALCULATIONS SIGNED AND SEALED BY AN ENGINEER LICENSED IN THE STATE WHERE THE PROJECT IS LOCATED VERIFYING THE ADEQUACY OF THE STRUCTURE FOR ANY PROPOSED CONSTRUCTION LOADS THAT ARE IN EXCESS OF THE STATED DESIGN LOADS. THE STRUCTURAL ENGINEER IS NOT RESPONSIBLE TO DESIGN OR CHECK THE STRUCTURE FOR LOADS APPLIED TO THE STRUCTURE FOR ANY CONSTRUCTION ACTIVITY.


# CONTRACTOR SUBSTITUTIONS

ANY MATERIALS OR PRODUCTS SUBMITTED FOR APPROVAL THAT ARE DIFFERENT FROM THE MATERIAL OR PRODUCTS SPECIFIED IN THE STRUCTURAL CONTRACT DOCUMENTS WILL BE APPROVED ONLY IF THE FOLLOWING CRITERIA ARE SATISFIED:

- 1. A COST SAVINGS TO THE OWNER IS DOCUMENTED AND SUBMITTED WITH THE REQUEST.
- 2. THE MATERIAL OR PRODUCT HAS BEEN APPROVED BY THE INTERNATIONAL CODE COUNCIL (ICC) AND THE ICC REPORT IS SUBMITTED WITH THE REQUEST.
- SUBMITTALS NOT SATISFYING THE ABOVE CRITERIA WILL NOT BE CONSIDERED.


# MAINTENANCE STATEMENT

ALL STRUCTURES REQUIRE PERIODIC MAINTENANCE TO EXTEND LIFESPAN AND TO ENSURE STRUCTURAL INTEGRITY FROM EXPOSURE TO THE ENVIRONMENT. A PLANNED PROGRAM OF MAINTENANCE SHALL BE ESTABLISHED BY THE BUILDING OWNER. THIS PROGRAM SHALL INCLUDE SUCH ITEMS SUCH AS BUT NOT LIMITED TO PAINTING OF STRUCTURAL STEEL, PROTECTIVE COATING FOR CONCRETE, SEALANTS, CAULKED JOINTS, EXPANSION JOINTS, CONTROL JOINTS, SPALLS AND CRACKS IN CONCRETE, AND PRESSURE WASHING OF EXPOSED STRUCTURAL ELEMENTS EXPOSED TO A SALT ENVIRONMENT OR OTHER HARSH CHEMICALS.

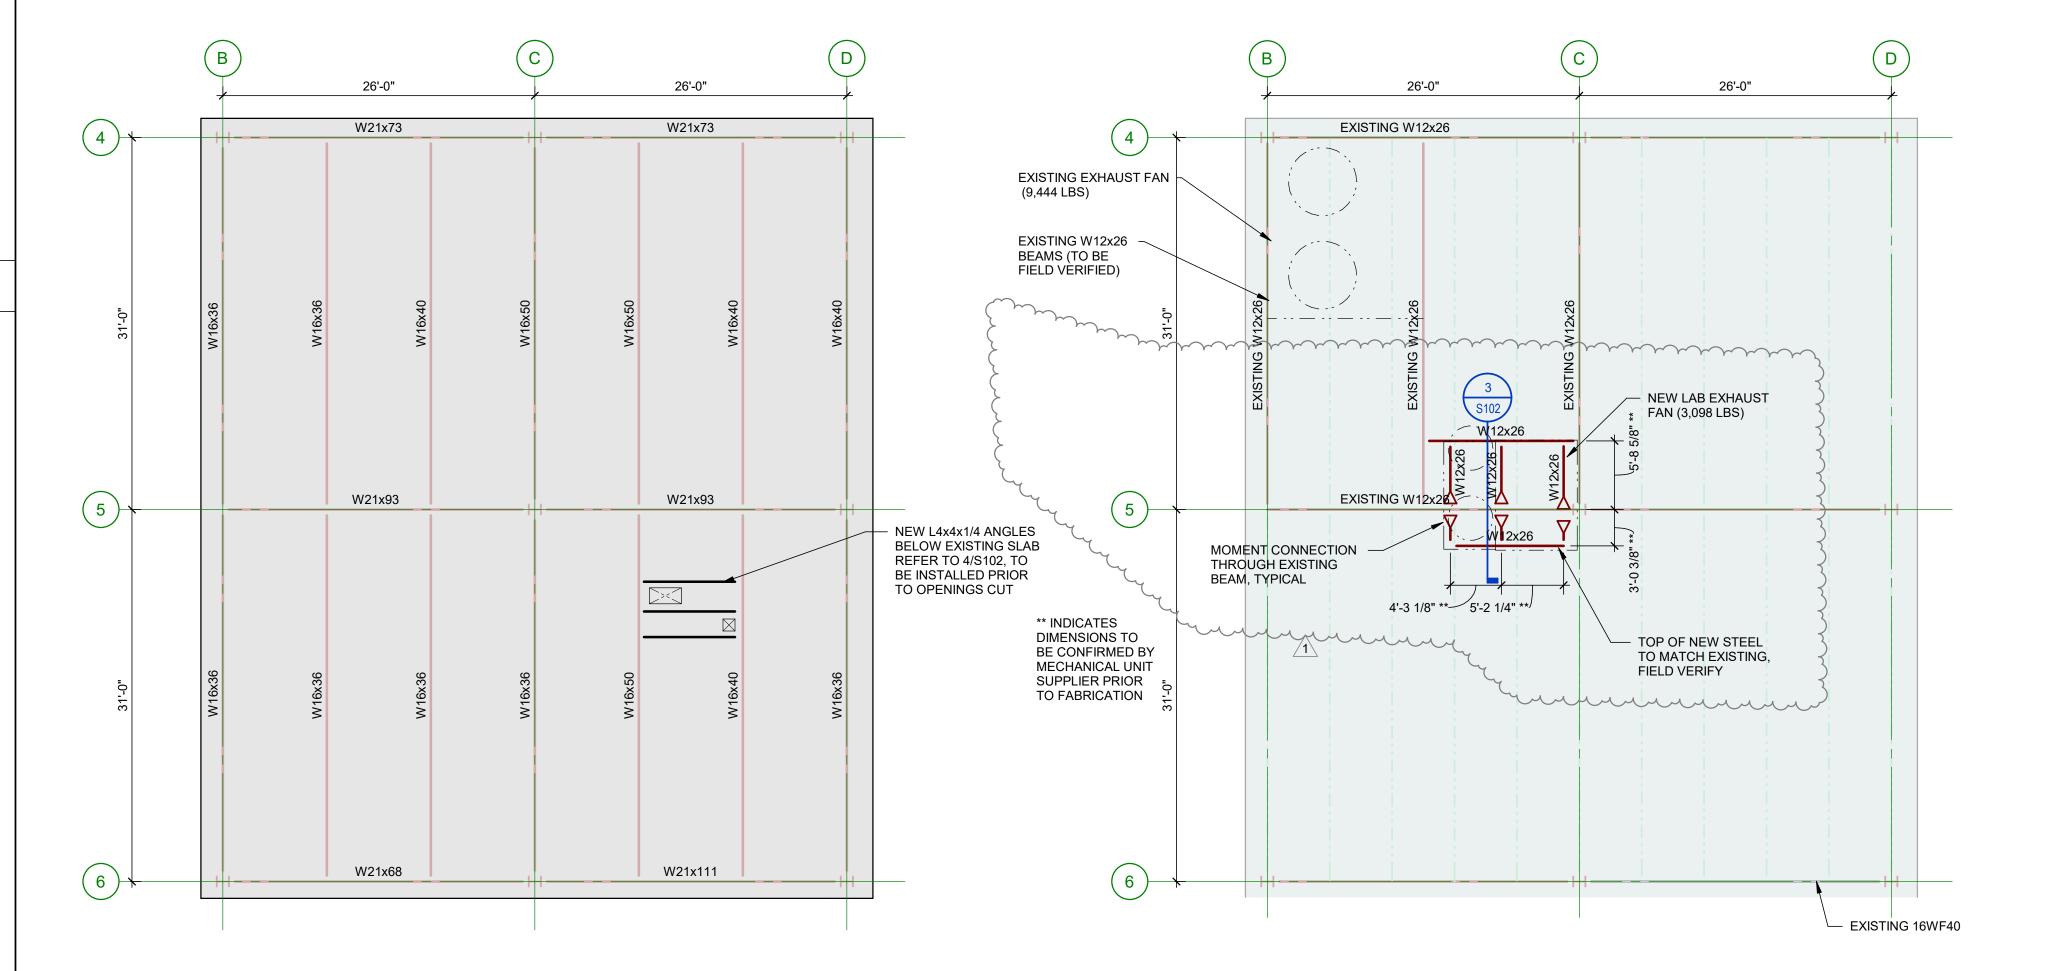

# PLAN NOTES

- BOTTOM OF DECK ELEVATION IS  $\underline{38'-0"}$  (VIF), UNLESS NOTED OTHERWISE ON PLAN. TOP OF STEEL ELEVATIONS FOR BEAMS AND GIRDERS SHALL BE DETERMINED FROM JOIST SEAT DEPTHS AND
- BOTTOM OF DECK ELEVATIONS. UNLESS NOTED OTHERWISE. 2. EXISTING ROOF SYSTEM IS ROOF DECK SUPPORTED BY STEEL JOISTS AND BEAMS. ROOF DECK IS 2" DEEP POURED GYPSUM DECK ON 1 1/2" INSULATION FOAM BOARD.
- PROVIDE A CONTINUOUS 1/4" BENT PLATE AT ALL ROOF EDGES AND OPENINGS, UNLESS NOTED
- 4. ALL STEEL THAT IS PERMANENTLY EXPOSED TO THE EXTERIOR OR IS PERMANENTLY IN UNCONDITIONED SPACE SHALL BE HOT-DIPPED GALVANIZED.
- REFER TO MECHANICAL, ELECTRICAL, AND PLUMBING DRAWINGS FOR PENETRATIONS NOT SHOWN. REFER TO TYPICAL DETAILS FOR ADDITIONAL STEEL REQUIREMENTS AT OPENINGS. EXHAUST FAN MANUFACTURER TO PROVIDE ANCHORAGE TO STEEL BEAMS BELOW.
- REFER TO TYPICAL DETAILS FOR GUY WIRE AND EXHAUST DUCT SUPPORTS.

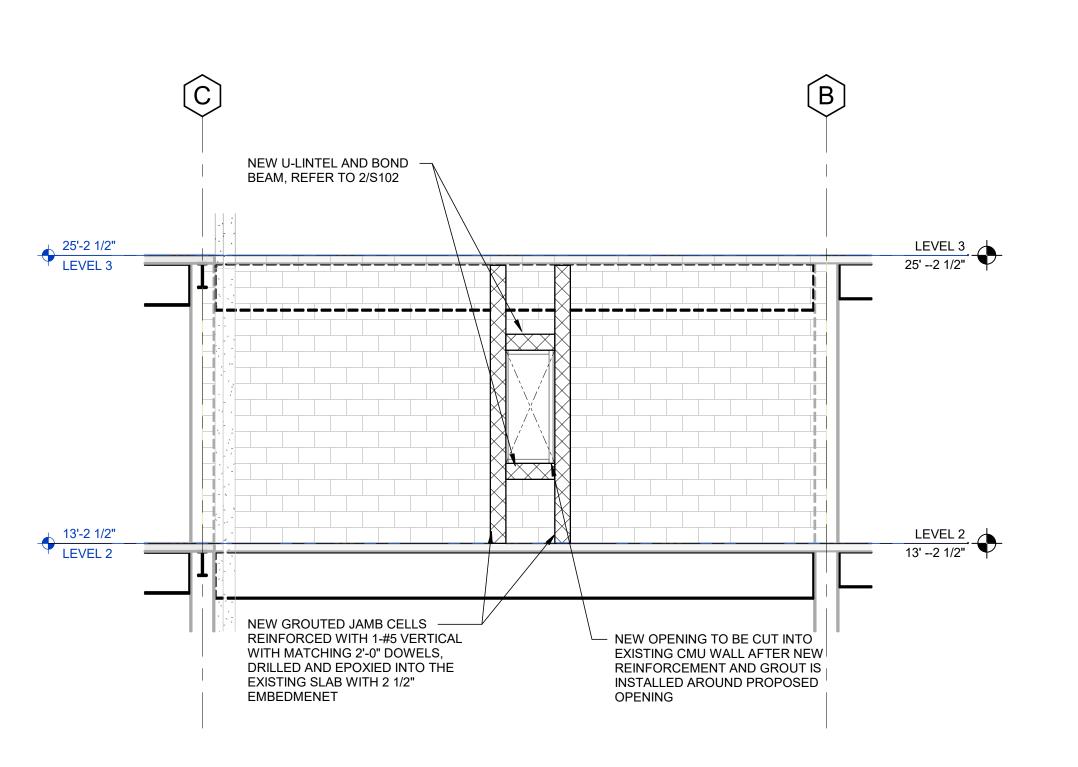

SECOND FLOOR EXTERIOR ELEVATION - NEW OFFICE WINDOW

LEVEL 3 FRAMING PLAN

**ARCHITECT** WALKER ARCHITECTS 2035 NW 13TH STREET GAINESVILLE, FL 32609 352.672.6448 AA26002009

**MEPF ENGINEER** AFFILIATED ENGINEERS 12921 SW 1 ROAD, #205 NEWBERRY, FL 32669 352.376.5500

STRUCTURAL ENGINEER WALTER P. MOORE 201 E KENNEDY BLVD #700 TAMPA FL 33602

813.221.2424

SEAL AND SIGNATURE

ALEX BIGGS P.E. FL LICENSE NO.: 68282

SUBMITTAL: ISSUE DATE: CONSTRUCTION DOCUMENTS 08/12/2025 REVISION DESCRIPTION DATE ADDENDUM-01 08/25/2025

> **FSU BIO UNIT ONE TEACHING**


FLORIDA STATE UNIVERSITY, 89 CHIEFTAN WAY, TALLAHASSEE, FL 32306

**KEY PLAN** 

DRAWING TITLE:

GENERAL STRUCTURAL NOTES AND ROOF PLAN


PROJECT NO.: 23055-00 DRAWN BY: Author CHECKED BY: Checker

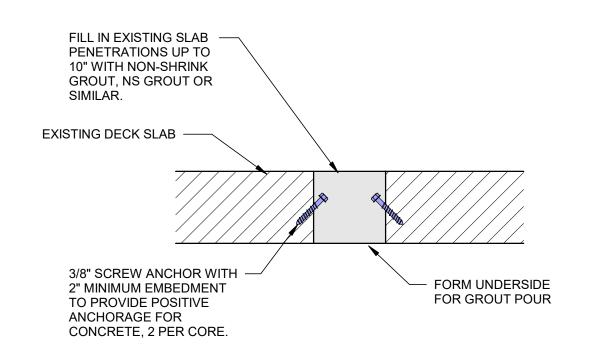


EXISTING DECK SLAB ----REINFORCING ANGLE, - PL 1/4x3x3 REFER TO PLAN CONNECTION PLATE - EXISTING STEEL BEAM NOTE: OPENINGS SMALLER THAN OPENINGS LARGER THAN 10", LESS THAN 2'-0" OR EQUIAL TO 10" DO NOT REQUIRE REINFORCEMENT BUT SUBMIT CORE LOCATIONS FOR REVIEW PRIOR TO CONSTRUCTION AND ENSURE EXISTING BEAMS AREN'T CONFLICTING.

GROUT EXISTING PENETRAION


ANGLE REINFORCEMENT CONNECTION

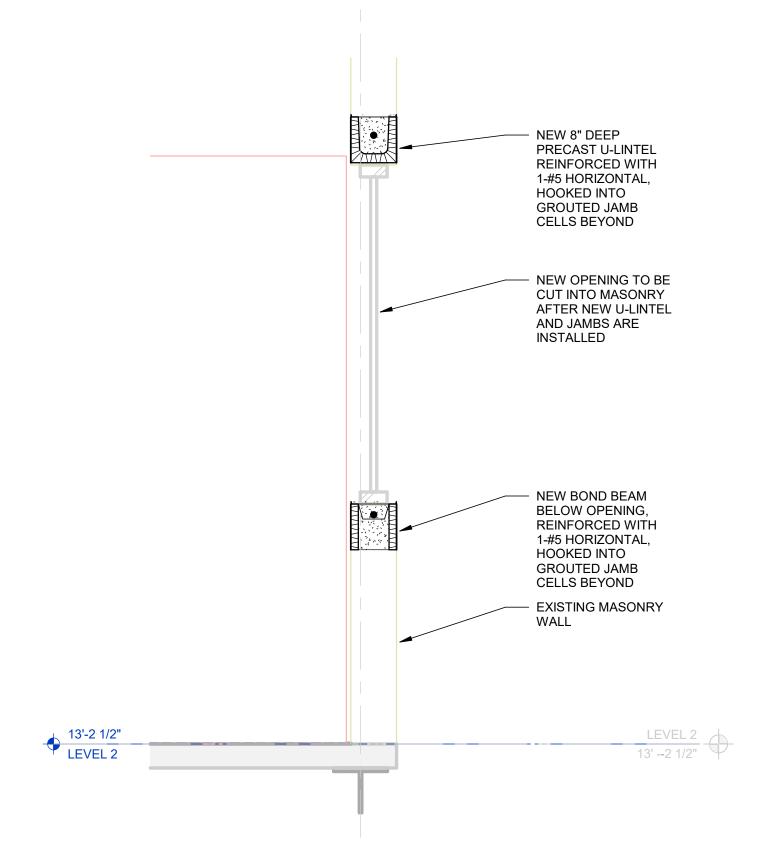


**NEW MASONRY OPENING** 

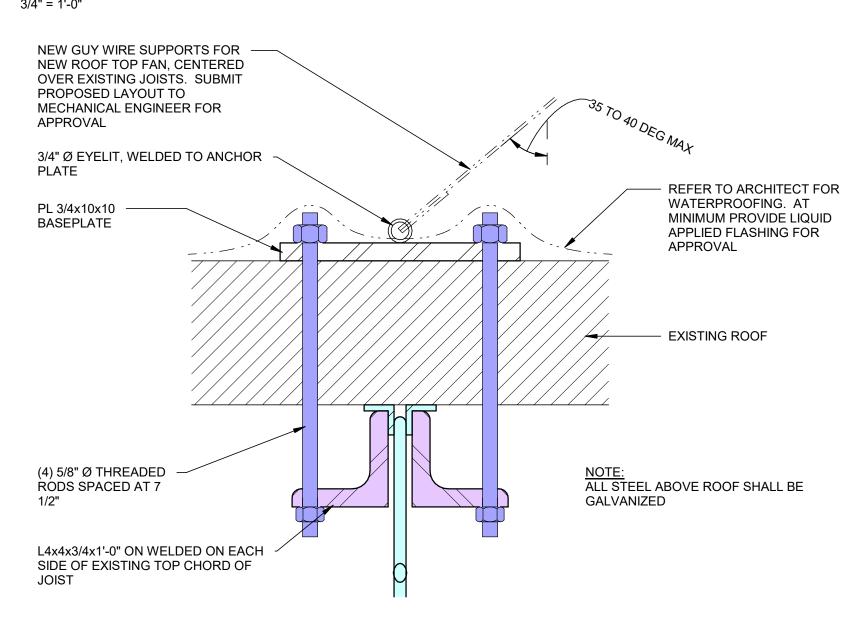




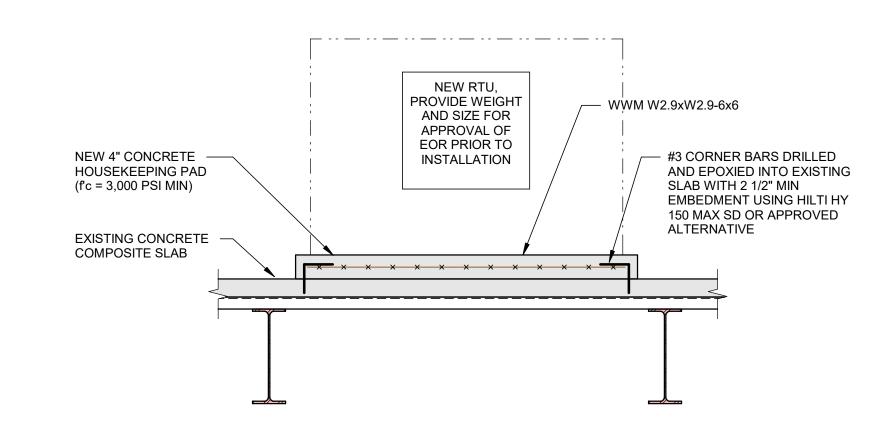

NEW HOUSEKEEPING PAD ON EXISTING

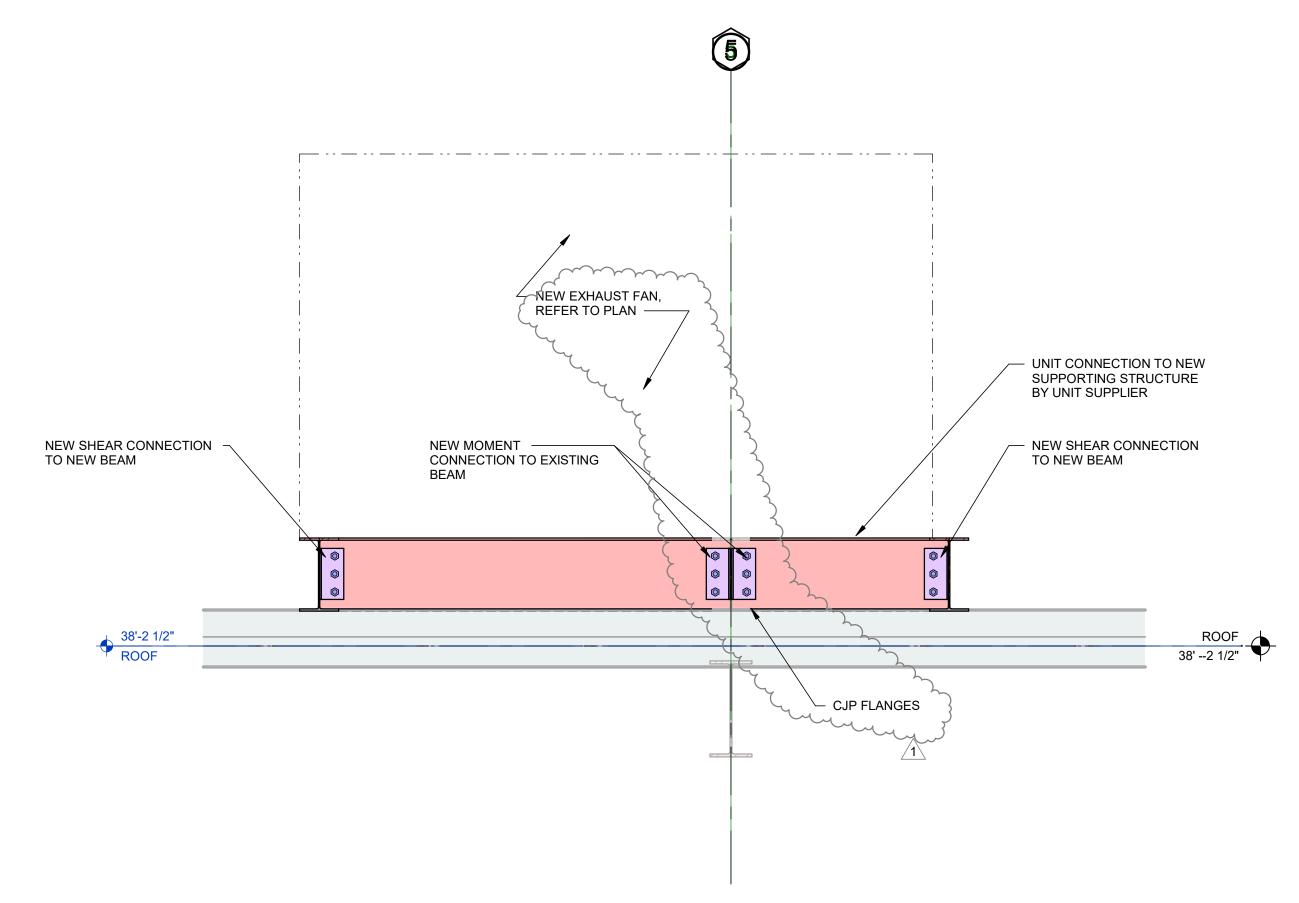

NEW ROOF FRAMING TO SUPPORT NEW EXHAUST FAN

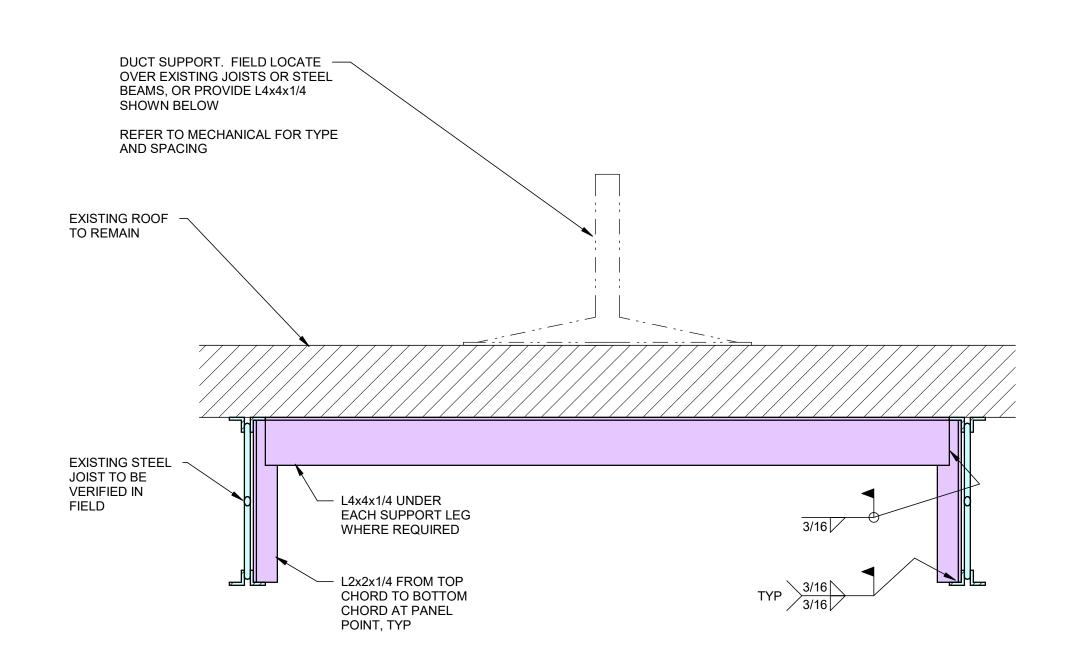

EXHAUST DUCT SUPPORTS

ARCHITECT

352.672.6448 AA26002009 **MEPF ENGINEER** 

WALKER ARCHITECTS 2035 NW 13TH STREET

GAINESVILLE, FL 32609

AFFILIATED ENGINEERS 12921 SW 1 ROAD, #205 NEWBERRY, FL 32669 352.376.5500

TAMPA FL 33602 813.221.2424

STRUCTURAL ENGINEER WALTER P. MOORE 201 E KENNEDY BLVD #700

SEAL AND SIGNATURE

ALEX BIGGS P.E. FL LICENSE NO.: 68282

SUBMITTAL: ISSUE DATE: CONSTRUCTION DOCUMENTS 08/12/2025 DATE REVISION DESCRIPTION ADDENDUM-01 08/25/2025

**FSU BIO UNIT** ONE TEACHING **LABS** 

FLORIDA STATE UNIVERSITY, 89 CHIEFTAN WAY, TALLAHASSEE, FL 32306

KEY PLAN

SECTIONS AND DETAILS

PROJECT NO.: 23055-00 DRAWN BY: Author

**S102** 

# **GENERAL NOTES**

- 1. DUE TO THE IMPORTANCE OF MAINTAINING OPERATIONS AT THIS FACILITY, CONTRACTOR SHALL COORDINATE WITH OWNER ALL WORK THAT REQUIRES THE SHUTDOWN OF EXISTING AND STARTUP OF NEW UTILITIES PRIOR TO START. WORK MAY BE REQUIRED TO BE PERFORMED AT NIGHT, ON WEEKENDS AND/OR OVER HOLIDAYS.
- 2. DUE TO CEILING SPACE LIMITATIONS, IT IS IMPERATIVE THAT DUCT/PIPE/EQUIPMENT INSTALLATION BE COORDINATED WITH ALL TRADES PRIOR TO INSTALLATION OF ANY ABOVE CEILING UTILITIES.
- 3. CONTRACTOR TO COORDINATE WITH ALL TRADES TO ENSURE ADEQUATE ACCESS IS PROVIDED TO PROPERLY MAINTAIN ALL AIR TERMINAL DEVICES, DUCT SMOKE DETECTORS, FIRE/SMOKE DAMPERS, CONTROL DAMPERS, AIR FLOW STATIONS, AND SIMILAR ABOVE CEILING EQUIPMENT. PROVIDE CEILING ACCESS PANELS TO SERVICE EQUIPMENT LOCATED ABOVE HARD CEILING AREAS. FOR BALANCING DAMPERS LOCATED ABOVE HARD CEILINGS AREAS, PROVIDE REMOTE OPERATED VOLUME CONTROL DAMPERS REFER TO SPECIFICATIONS.
- 4. ALL DIFFUSERS, GRILLES, ETC. SHALL HAVE MANUAL VOLUME DAMPERS INSTALLED IN DUCTWORK FOR BALANCING EACH DEVICE. SPACES SERVED BY A SINGLE DIFFUSER, GRILLE, CHILLED BEAM, ETC. DOWNSTREAM FROM IT'S RESPECTIVE AIR TERMINAL DEVICE DO NOT REQUIRE THE MANUAL VOLUME
- FOR CLARITY, NOT ALL DEVICES ARE SHOWN ON FLOOR PLANS. REFER TO FLOW DIAGRAMS, DETAILS AND CONTROL DRAWINGS SCHEDULES AND SPECIFICATIONS FOR ADDITIONAL DEVICES.
- 6. WORK SHOWN HEREIN IS INTENDED TO SHOW END RESULT AND DOES NOT FULLY IMPLY SEQUENCING OF WORK. CONTRACTOR TO ESTABLISH WORK SEQUENCE VIA COORDINATION WITH OWNER, REVIEW OF EXISTING CONDITIONS AND REVIEW OF PHASING PLANS.

# SHEET KEYNOTES (#)

- 6Ø GE W/ CONNECTION TO SNORKEL ASSEMBLY -BALANCE TO 80 CFM.
- 6Ø GE DN WITH CONNECTION TO VENTILATED CABINET - BALANCE TO 55 CFM.
- 3. NEW LOCATION FOR EXISTING FCU 2-4.
  REPIPE/RECONNECT ALL ASSOCIATED FCU PIPING
  (CHW, HHW & D), CONTROL WIRING FROM
  EXISTING LOCATIONS TO NEW FCU LOCATION AS
- 4. OFFSET EXHAUST DUCTWORK ON LEVEL ABOVE TO AVOID ROOF JOISTS.
- COORDINATE FINAL FAN COIL UNIT ELEVATION AND LOCATION WITH IT EQUIPMENT.



ARCHITECT

WALKER ARCHITECTS
2035 NW 13TH STREET
GAINESVILLE, FL 32609

352.672.6448 AA26002009

MEPF ENGINEER

AFFILIATED ENGINEERS

12921 SW 1 ROAD, #205

NEWBERRY, FL 32669

352.376.5500

STRUCTURAL ENGINEER

WALTER P. MOORE

201 E KENNEDY BLVD #700

TAMPA FL 33602

813.221.2424

SEAL AND SIGNATURE

ENGINEER OF RECORD
RICHARD DAVID COKER FL P.E NO. 91827

08/25/2025

SUBMITTAL: ISSUE DATE:

CONSTRUCTION DOCUMENTS 08/12/2025

REVISION DESCRIPTION DATE

ADDENDUM-01

FSU BIO UNIT
ONE TEACHING
LABS

FLORIDA STATE UNIVERSITY, 89 CHIEFTAN WAY, TALLAHASSEE, FL 32304

KEY PLAN



DRAWING TITLE:

LEVEL 2 MECHANICAL DUCT PLAN

PROJECT NO.: 23055-00 DRAWN BY: WB CHECKED BY: RDC

M102

# **GENERAL NOTES**

- 1. DRAWING IS TYPICAL AND MAY REPRESENT MORE THAN ONE SYSTEM.
- 2. COORDINATE THE INSTALLATION AND FINAL LOCATION OF INSTRUMENTS WITH OTHER
- 3. VERIFY ALL CABLE REQUIREMENTS PRIOR TO TERMINATING.
- 4. PROVIDE FINAL I/O ADDRESS, CABLE TAGS, MEDIUM TYPE, ETC.
- 5. SETPOINTS, TIMERS, DELAYS AND ALARM LIMITS ARE ADJUSTABLE AND SHALL BE COORDINATED WITH TAB ENGINEER, MECHANICAL SCHEDULES AND CONTROL DIAGRAMS.
- 6. PROVIDE ALL LABOR, MATERIALS, SERVICES, EQUIPMENT, AND DEVICES NECESSARY FOR A COMPLETE, FULLY FUNCTIONAL BUILDING AUTOMATION SYSTEM AS INTENDED IN THE SEQUENCES OF OPERATION, SPECIFICATIONS, AND CONTROL DRAWINGS.
- 7. ALARM SHALL BE GENERATED IF ANY CONTROL VARIABLE (AIRFLOW, TEMPERATURE, HUMIDITY, PRESSURE, LIGHTING CONTROL, ETC.) IS NOT MEETING SETPOINT OR STATUS IS NOT MATCHING

# SHEET KEYNOTES

ALARM CONDITION

- $\sim$ 1. DUCT MOUNTED SMOKE DETECTOR PROVIDED BY DIVISION 28. REFER TO FLOORPLANS FOR DETECTOR LOCATION. 2. MULTIPLE FANS SERVED BY REDUNDANT VFDS.
- PROVIDE SEPARATE CURRENT SWITCHES FOR EACH FAN AND REPORT BACK EACH INDIVIDUAL FAN STATUS. REFER TO SCHEDULES FOR TOTAL
- 3. FIRE ALARM SHUT DOWN RELAY CONNECTION. ··················/<sub>1</sub>

# MIXED AIR UNIT - CONTROL SEQUENCE

- 1. VARIABLE AIR VOLUME AIR HANDLING SYSTEM DISTRIBUTES AIR TO VAV AIR TERMINAL UNITS. 2. SYSTEM OPERATION: a. SYSTEM SHALL OPERATE CONTINUOUSLY (24 HOURS PER DAY, 365 DAYS PER YEAR).
- B. START UP: 1. UPON START UP COMMAND:
- a. RETURN AIR DAMPER OPENS FULLY.
- b. OUTSIDE AIR DAMPER SHALL OPEN AND BE PROVEN. c. SUPPLY FAN VFD SHALL START SUPPLY FANS; VFD AND EACH FAN SHALL BE PROVEN.
- d. SUPPLY FAN STATIC PRESSURE CONTROL SEQUENCE ACTIVATES. e. SUPPLY DUCT STATIC PRESSURE RESET ACTIVATES.
- f. COOLING COIL TEMPERATURE CONTROL SEQUENCE ACTIVATES. g. SUPPLY AIR TEMPERATURE RESET CONTROL SEQUENCE ACTIVATES.
- C. SHUTDOWN:
- 1. UPON SHUTDOWN COMMAND: a. ALL SUPPLY FANS SHALL STOP AND BE PROVEN BY CURRENT SENSING DEVICES.
- b. ALL ASSOCIATED DAMPERS IN SYSTEM SHALL CLOSE. c. ALL OTHER SEQUENCES DISABLE. d. NUISANCE ALARMS ARE SUPPRESSED.
- D. SUPPLY FAN STATIC PRESSURE CONTROL:
- 1. SUPPLY FAN VFD SPEED MODULATES TO MAINTAIN SUPPLY DUCT STATIC PRESSURE SETPOINT.
- E. SUPPLY DUCT STATIC PRESSURE RESET: 1. PERFORM EVERY 15 MINUTES (ADJ).
- 2. IF ANY VAV BOX DAMPER COMMAND IS GREATER THAN 90% (ADJ), INCREASE DUCT STATIC PRESSURE SETPOINT BY 0.1 IN.WG. 3. IF ALL VAV BOX DAMPER COMMANDS ARE LESS THAN 60% (ADJ), DECREASE DUCT STATIC

  PRESSURE SETPONY BYO. MN. WG.

### F. COOLING COIL TEMPERATURE CONTROL: 1. COOLING COIL VALVE MODULATES TO MAINTAIN ACTIVE COOLING COIL LEAVING AIR

- TEMPERATURE SETPOINT. G. COOLING COIL TEMPERATURE SETPOINT RESET CONTROL:
- 1. RESET SEQUENCE IS ONLY ACTIVE WHEN STATIC PRESSURE SETPOINT IS AT MINIMUM. 2. RESET THE COOLING COIL LEAVING AIR TEMPERATURE SETPOINT BASED ON THE FOLLOWING
- SCHEDULE: a. 50% (ADJ) OF THE ZONES SERVED HAVE A REHEAT VALVE COMMAND AT 75% (ADJ) OR
- HIGHER: INCREASE ACTIVE SETPOINT 1 DEG F EVERY 10 MINUTES (ADJ) UNTIL 75% (ADJ) OF ZONE REHEAT COIL COMMANDS ARE BELOW 65% (ADJ).
- b. 75% (ADJ) OF THE ZONES SERVED HAVE A REHEAT VALVE COMMAND AT 25% (ADJ) OR LOWER: DECREASE ACTIVE SETPOINT 1 DEG F EVERY 10 MINUTES (ADJ) UNTIL 50% (ADJ) OF ZONE REHEAT COIL COMMANDS ARE ABOVE 35% (ADJ).
- 3. COOLING COIL TEMPERATURE SETPOINT RESET STOPS WHEN ANY ZONE HUMIDITY SENSOR MEASURES 50% RH OR GREATER.

/www.www.ww/

- 1. OUTSIDE AIR DAMPER MODULATES TO MAINTAIN OUTSIDE AIRFLOW SETPOINT. 2. IF OUTSIDE AIR DAMPER IS 100% OPEN, RETURN AIR DAMPER MODULATES TO MAINTAIN
- I. OUTSIDE AIR FLOW SETPOINT RESET: 1. EVERY 15 MIN. (ADJ), OUTSIDE AIR FLOW SETPOINT SHALL BE RESET WITH ACCORDING TO THE FOLLOWING EQUATION:
- OUTSIDE AIR FLOW SETPOINT = TOTAL EXHAUST AIR FLOW + 300 CFM J. LEAD/STANDBY ROTATION FOR PRIMARY/REDUNDANT VARIABLE FREQUENCY DRIVES:
- 1. AUTOMATICALLY ROTATE LEAD/STANDBY DESIGNATIONS FOR DRIVE A AND DRIVE B EACH WEEK TO EQUALIZE RUN TIME. 2. LEAD/STANDBY ROTATION SHALL PROVIDE SEAMLESS TRANSITION FROM DRIVE A TO
- DRIVE B WITHOUT ANY LOSS OF AIR FLOW. 3. OPERATOR SHALL BE ABLE TO MANUALLY OVERRIDE LEAD/STANDBY DESIGNATIONS.
- K. SAFETIES: 1. THE FOLLOWING SAFETIES SHUT DOWN SUPPLY FAN AND ACTIVATE SHUT DOWN
- SEQUENCE: a LOW STATIC PRESSURE LIMIT SWITCH b. HIGH STATIC PRESSURE LIMIT SWITCH
- c. DRAIN PAN FLOAT SWITCH ALARM

IS ACTIVATED.

OUTSIDE AIRFLOW SETPOINT.

- 2. IF THE LOW TEMPERATURE ALARM (FREEZESTAT) IS TRIPPED, INITIATE SHUTDOWN SEQUENCE AS DESCRIBED, AND IN ADDITION, COMMAND CHILLED WATER CONTROL
- VALVE FULLY OPEN. THE LOW TEMPERATURE ALARM MUST BE MANUALLY RESET. ONCE MANUALLY RESET, THE AHU SYSTEM SHALL RESTART AUTOMATICALLY. 3. SYSTEM SHALL CONTINUE TO OPERATE IN NORMAL MODE IF THE BUILDING FIRE ALARM
- 4. UPON ACTIVATION DUCT SMOKE DETECTOR ASSOCIATED WITH THE AIR HANDLING UNIT, ACTIVATE SHUTDOWN SEQUENCE.
- .. RESTORATION OF POWER: 1. UPON RESTORATION OF POWER AFTER POWER OUTAGE, ALL ALARMS ASSOCIATED
- WITH POWER LOSS SHALL BE RESET AND AIR HANDLING UNIT SYSTEM SHALL RESTART AS DESCRIBED IN START-UP SEQUENCE ABOVE.

TAG	POINT DESCRIPTION	UNITS	ANALOG	DIGITAL	INTEGRATED	SETPOINT VALUE	EQUIP ALARM	HIGH LIMIT	LOW LIMIT
HARDWARE					\ \\\\\\\\\\\\\\\\\\\\\\\\\\\\\\\\\\\\		5		
CY 01	SUPPLY FAN VFD COMMAND	ON/OFF		Х			X		
CY 02	SUPPLY FAN VFD DUTY DRIVE COMMAND	DRIVE A/DRIVE B		Х	<u> </u>	-	₹ ×		
FCV 01	OUTSIDE AIR DAMPER COMMAND	% OPEN	X		}	-	$\mathbf{R}$		
FCV 02	RETURN AIR DAMPER COMMAND	% OPEN	Х		\		<u> </u>		
FT 01	OUTSIDE AIRFLOW RATE	CFM	X		<u>ς</u>		3		
IS 01	SUPPLY FAN STATUS	ON/OFF		Х			X		
LS 01	COOLING COIL DRAIN PAN FLOAT SWITCH	NORMAL/ALARM		Х	<del>                                     </del>	-	₹		
MT 01	RETURN AIR HUMIDITY	% RH	X		3	<b>-</b>	$\rightarrow$		
PDT 01	PREFILTER DIFFERENTIAL PRESSURE	IN. WG.	X		\ \\\\\\\\\\\\\\\\\\\\\\\\\\\\\\\\\\\\		) x		
PDT 02	FINAL FILTER DIFFERENTIAL PRESSURE	IN. WG.	X				3 ×		
PDT 03	ENEGRY RECOVERY COIL PREFILTER DIFFERENTIAL PRESSURE	IN. WG.	X		<u> </u>	•	1 X		
PSHA 01	HIGH STATIC PRESSURE LIMIT ALARM	NORMAL/ALARM		Х	$\rightarrow$	-	₹		
PSLA 01	LOW STATIC PRESSURE LIMIT ALARM	NORMAL/ALARM		Х	\		$\supset$		
PT 01	SUPPLY AIR STATIC PRESSURE	IN WG	X		Γ,		3	Х	Х
SC 01	SUPPLY FAN VFD SPEED COMMAND	%	Х				1		
TCV 02	COOLING COIL CONTROL VALVE	% OPEN	X			-	<b>3</b>		
TE 01	ENERGY RECOVERY COIL LEAVING WATER TEMPERATURE	DEG F	Х		}		$\mathcal{L}$	X	Х
TE 02	ENERGY RECOVERY COIL ENTERING WATER TEMPERATURE	DEG F	Х		\ \ \ \ \ \	1	3	X	Х
TE 03	ENERGY RECOVERY COIL LEAVING AIR TEMPERATURE	DEG F	Х				1	X	X
TE 04	COOLING COIL LEAVING AIR TEMPERATURE	DEG F	X			-	1	X	X
TE 05	COOLING COIL ENTERING AIR TEMPERATURE	DEG F	X		}	•	2	Х	X
TE 06	SUPPLY AIR TEMPERATURE	DEG F	X		<u> </u>		<u> </u>	X	X
TE 07	RETURN AIR TEMPERATURE	DEG F	X				3	X	X
TE 08	OUTSIDE AIR TEMPERATURE	DEG F	X			<b>-</b>	<b>1</b>	X	X
TE 09	COOLING COIL LEAVING WATER TEMPERATURE	DEG F	X		}	<b>-</b>	7		
TSLA 01	LOW TEMPERATURE LIMIT SWITCH	NORMAL/ALARM		X	<b></b> }		2		
					<b></b>		3		
SOFTWARE				.,	<b></b>		3	ļ	
SDP	SYSTEM START-UP	ON/OFF		Х	\ \ \ \ \ \ \ \ \ \ \ \ \ \ \ \ \ \ \	(0)	⋠——		
SDP	STATIC PRESSURE SETPOINT	IN WG	X		<b></b> }	(2)			$\vdash$
SDP	STATIC PRESSURE MINIMUM SETPOINT	IN WG	X		<b>\</b>	, <u> </u>	<del>)</del> —		$\vdash$
SDP	STATIC PRESSURE MAXIMUM SETPOINT	IN WG	X		\ <u>`</u>	(4)	}		<del></del>
SDP	ACTIVE COOLING COIL LEAVING AIR TEMPERATURE SETPOINT	DEG F	X		<del>                                     </del>	(4)	₹		<del></del>
SDP SDP	COOLING COIL LEAVING AIR TEMPERATURE MINIMUM SETPOINT	DEG F	X		<del>                                     </del>	48	<del>{</del>	-	<del></del>
SDP	COOLING COIL LEAVING AIR TEMPERATURE MAXIMUM SETPOINT	DEG F	X		<del>                                     </del>	55	<del>}</del>	<del>                                     </del>	$\vdash$
SDP	SUPPLY FAN VFD POINTS (1) OUTSIDE AIRFLOW SETPOINT	CFM	X		X (	<u> </u>	5—		$\vdash$
SDP	TOTAL EXHAUST AIR FLOW	CFM	X		<del>- (</del>	<u> </u>	1	<del>                                     </del>	$\vdash$
SDP		CFM	X		<del>                                     </del>		₹	<del>                                     </del>	$\vdash$
SUF	TOTAL SUPPLY AIR FLOW (3)	CFIVI	^		<del>                                     </del>	<u> </u>	₹	<del>                                     </del>	$\vdash$
		1			<b></b>		<b>5</b>		

POINT TYPE

REFER TO "TYPICAL VARIABLE FREQUENCY DRIVE (VFD) - INTEGRATED SOFTWARE POINTS" CONTROL DIAGRAM FOR SOFTWARE POINTS TO BE MAPPED BACK TO THE BAS.

(2) STATIC PRESSURE SETPOINTS TO BE DETERMINED BY TEST AND BALANCE IN FIELD.

(3) YOTACIZE ALC SYSVEMISORPLY AIR TERMINADA INFLOWS FOR POPULATION OF THE PLANT PLANT PLANT PLANT PROVIDE TO TALS UPPLY AIR PLOWS. (4) DEFAULT VALUE SHALL BE EQUAL TO THE COOLING COIL LEAVING DB TEMP AS SCHEDULED ON THE AIR HANDLING UNIT SCHEDULE. Munimum minum many mangaration of the contraction o

WORKSTATION

AHU 2-1 CONTROL DIAGRAM

SCALE: 12" = 1'-0"

**ARCHITECT** WALKER ARCHITECTS 2035 NW 13TH STREET GAINESVILLE, FL 32609 352.672.6448 AA26002009

**MEPF ENGINEER** 

AFFILIATED ENGINEERS 12921 SW 1 ROAD, #205 NEWBERRY, FL 32669 352.376.5500

STRUCTURAL ENGINEER

WALTER P. MOORE 201 E KENNEDY BLVD #700 TAMPA FL 33602 813.221.2424

SEAL AND SIGNATURE

ENGINEER OF RECORD RICHARD DAVID COKER FL P.E NO. 91827

ISSUE DATE: CONSTRUCTION DOCUMENTS 08/12/2025 DATE REVISION DESCRIPTION

08/25/2025

ADDENDUM-01

**FSU BIO UNIT** 


ONE TEACHING


FLORIDA STATE UNIVERSITY, 89 CHIEFTAN WAY, TALLAHASSEE, FL 32304

KEY PLAN

AHU 2-1 MECHANICAL **CONTROLS DIAGRAM** 

PROJECT NO.: 23055-00 DRAWN BY: EJV CHECKED BY: RDC

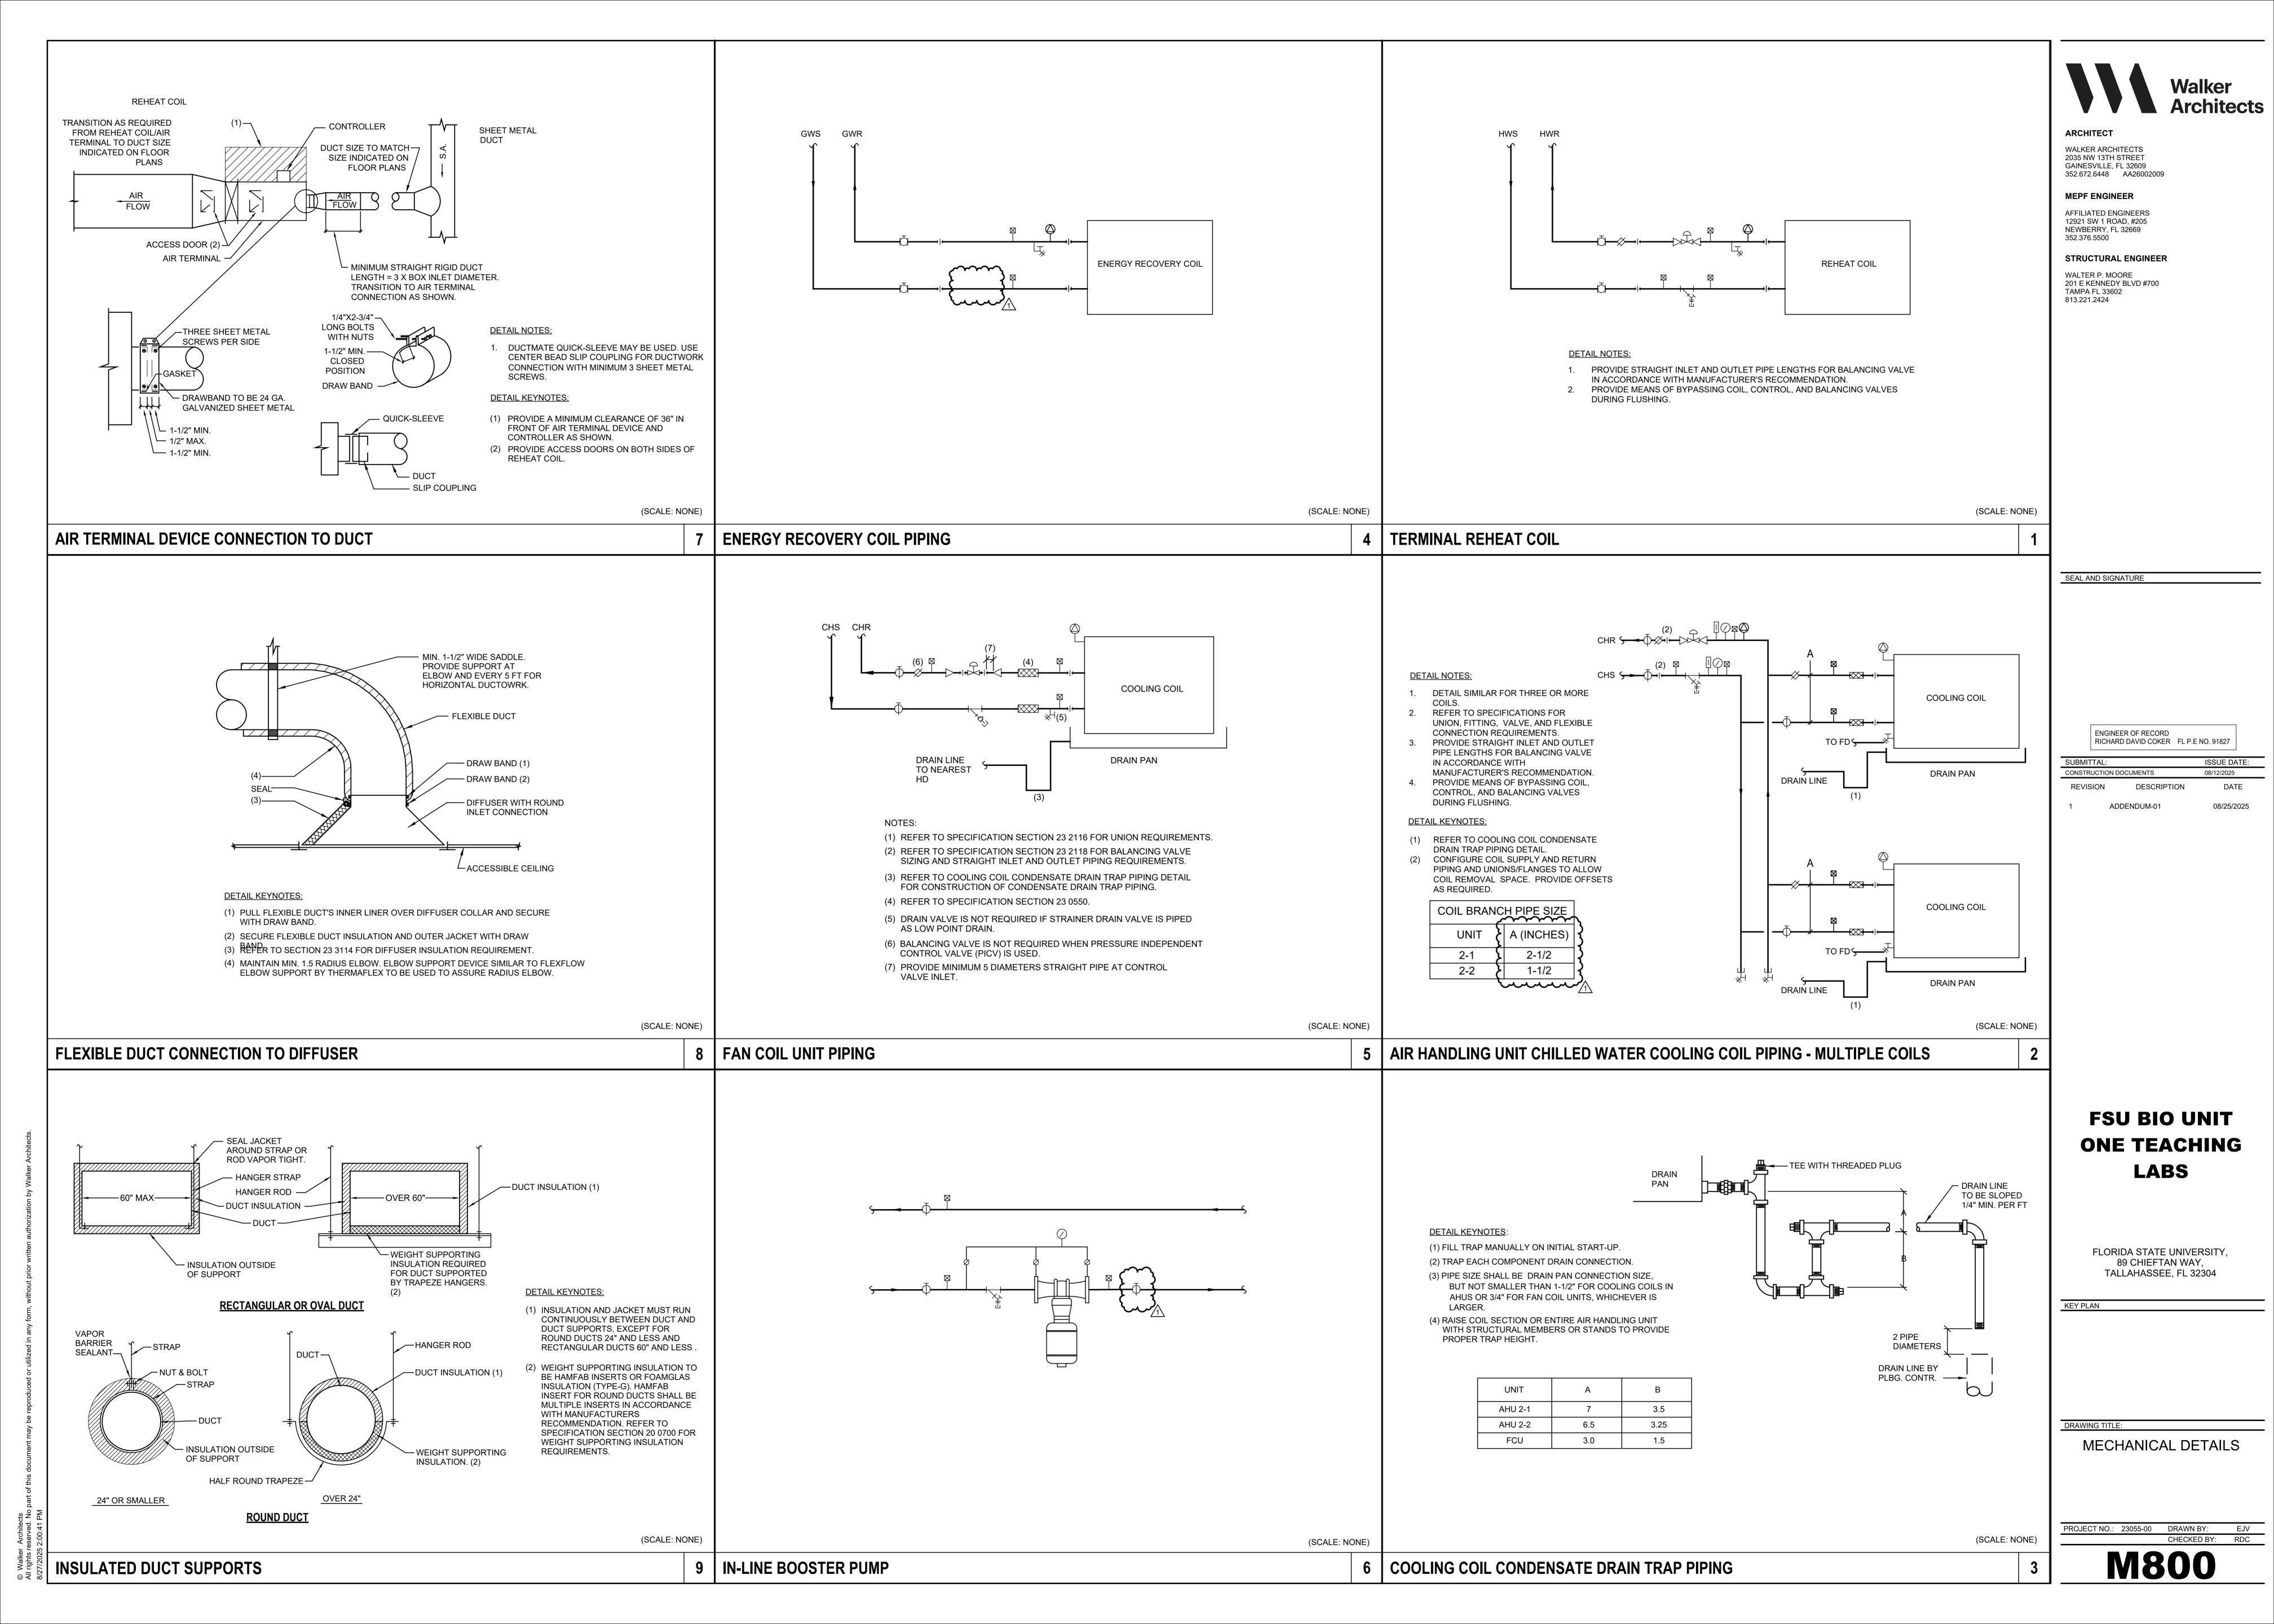

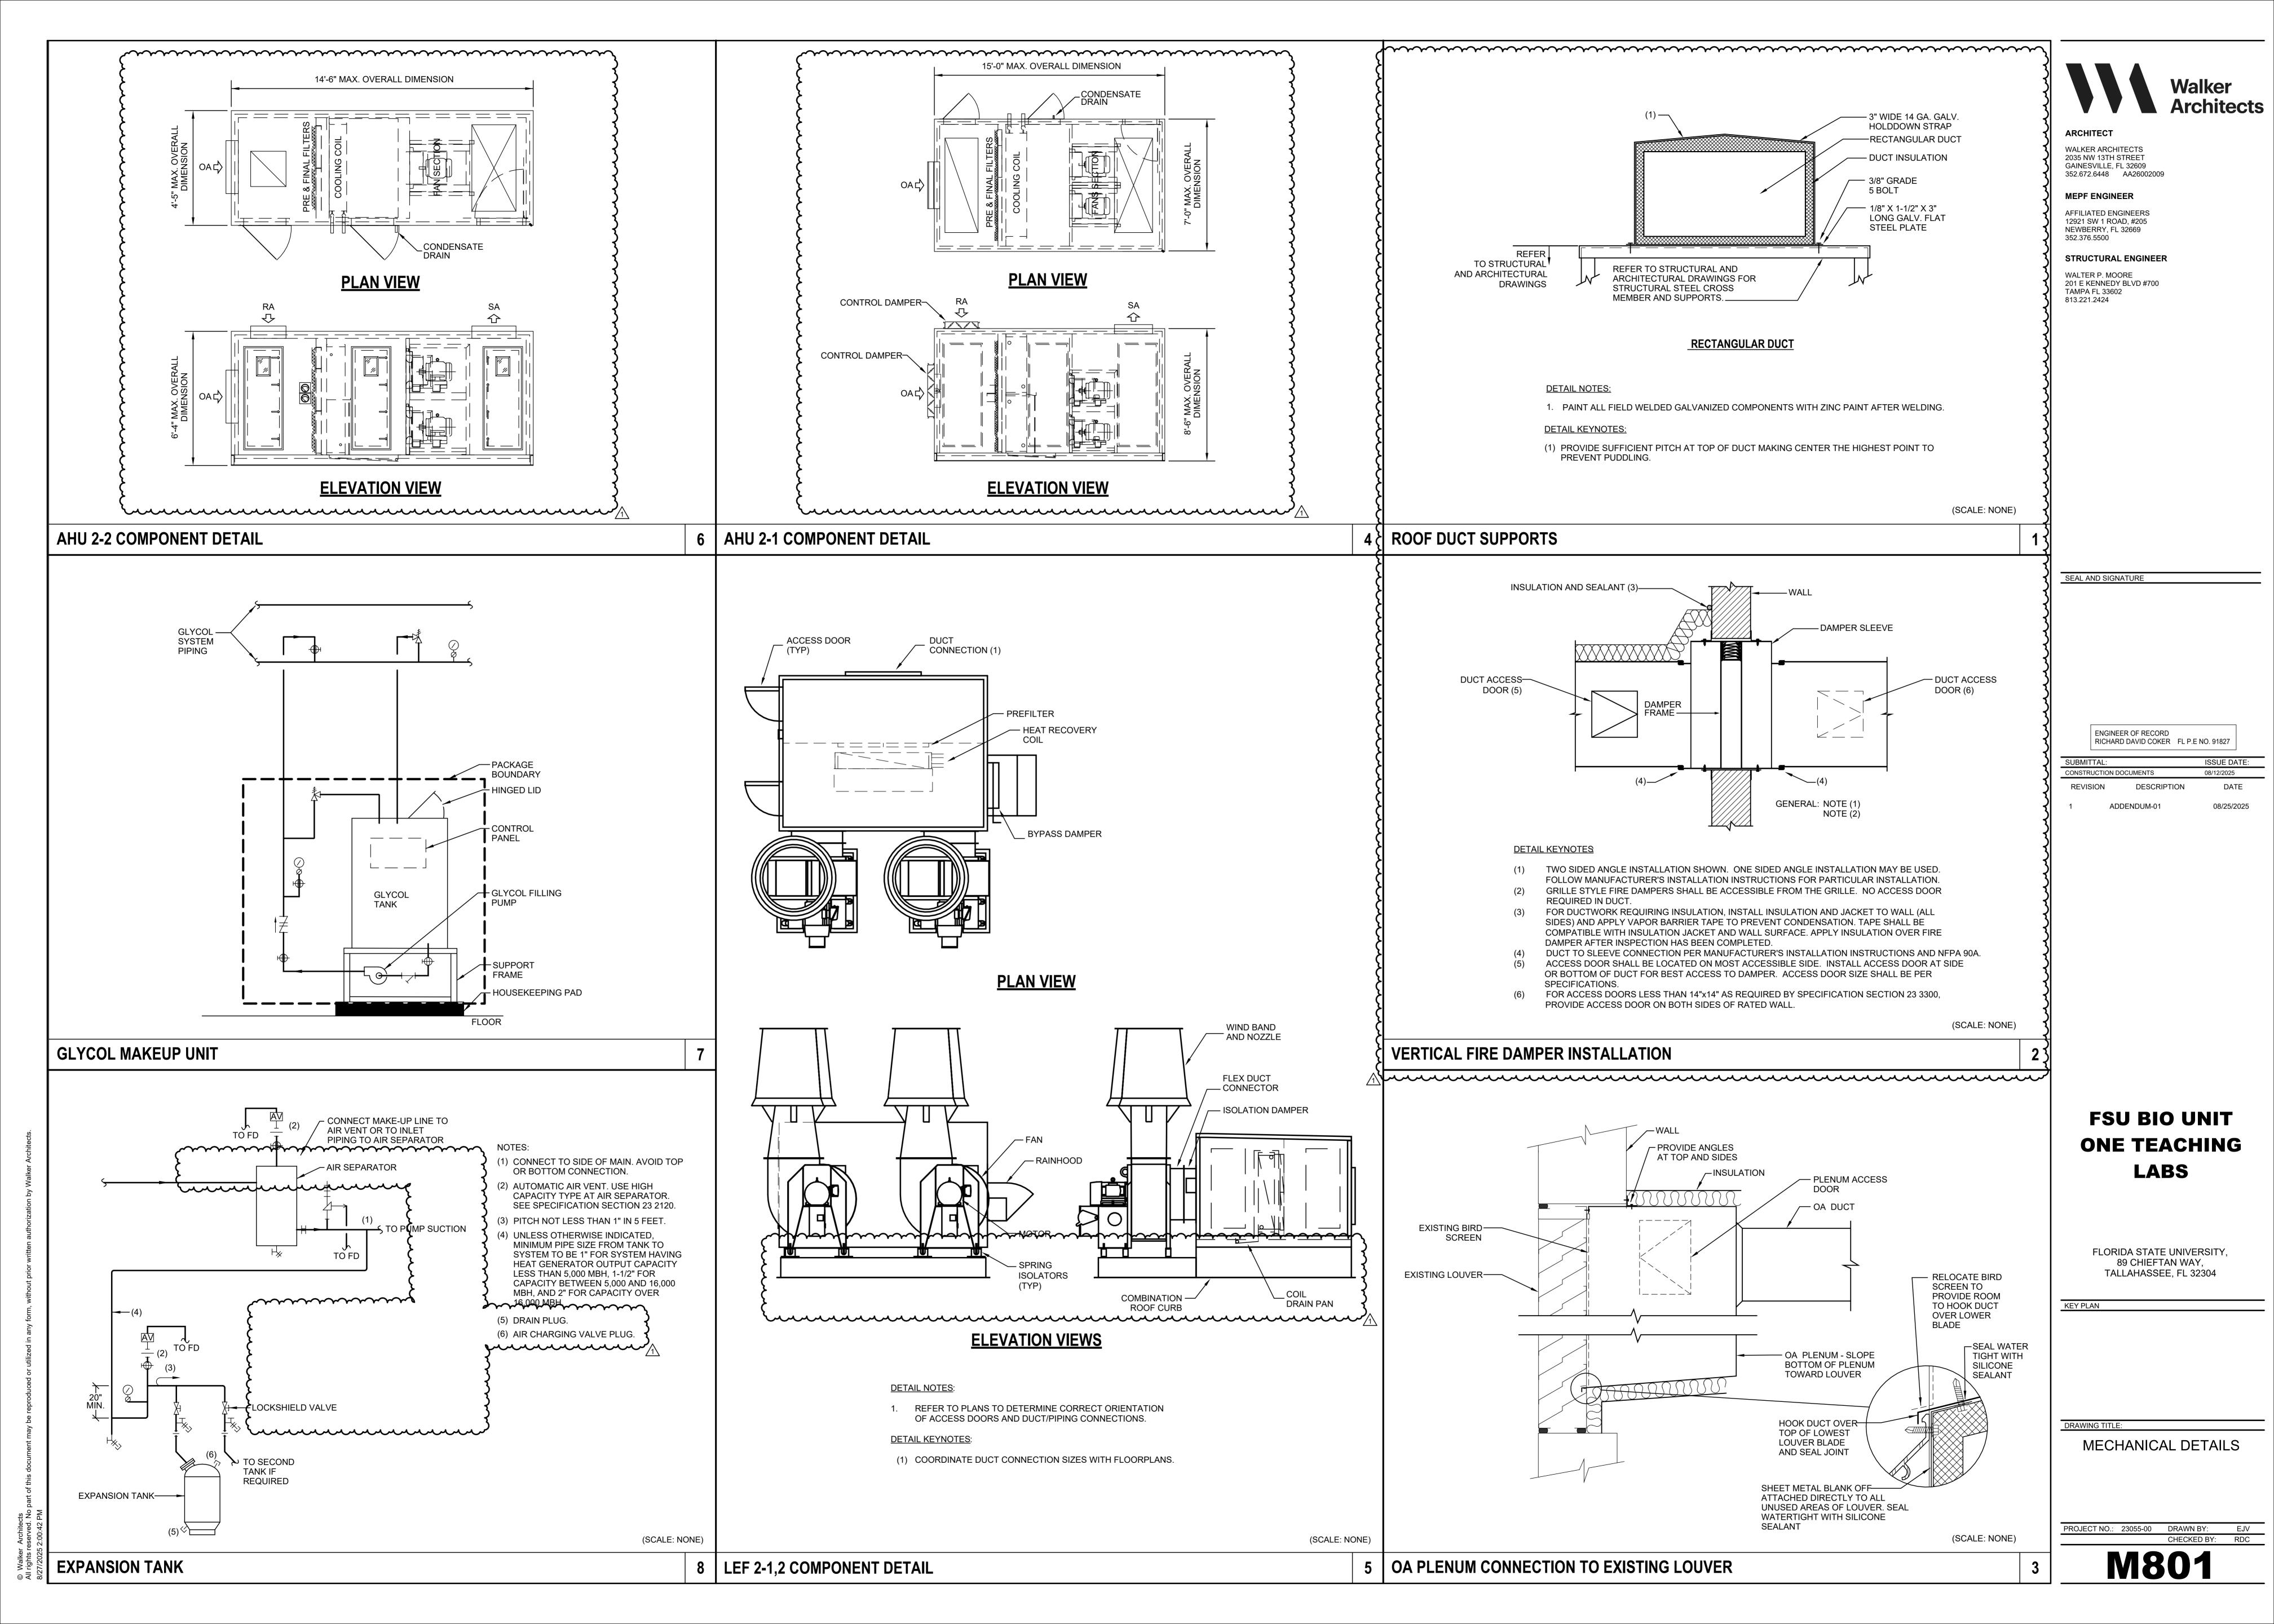

(1) BASIS OF DESIGN: WILLIAMS LH003W2R406R000

0242 MECHANICAL ERW

(1) BASIS OF DESIGN: TACO CBX

Wal Arcl

WALKER ARCHITECTS 2035 NW 13TH STREET GAINESVILLE, FL 32609 352.672.6448 AA26002009

MEPF ENGINEER

AFFILIATED ENGINEERS 12921 SW 1 ROAD, #205 NEWBERRY, FL 32669 352.376.5500

WALTER P. MOORE 201 E KENNEDY BLVD #700 TAMPA FL 33602 813.221.2424

SEAL AND SIGNATURE

SUBMITTAL: ISSUE DATE:

CONSTRUCTION DOCUMENTS 08/12/2025

ADDENDUM-01 DATE 08/25/2025

ADDENDUM-01

# FSU BIO UNIT ONE TEACHING LABS

FLORIDA STATE UNIVERSITY, 89 CHIEFTAN WAY, TALLAHASSEE, FL 32304

KEY PLAN

DRAWING TITLE:

**EXPANSION TANKS** 

LENGTH SYSTEM PRESSURE

CONN.

3/4

(IN)

VOLUME

(GAL)

REPLACEABLE BLADDER

VOLUME

(GAL)


2.5

14

MECHANICAL SCHEDULES

PROJECT NO.: 23055-00 DRAWN BY: EJV
CHECKED BY: RDC

M900

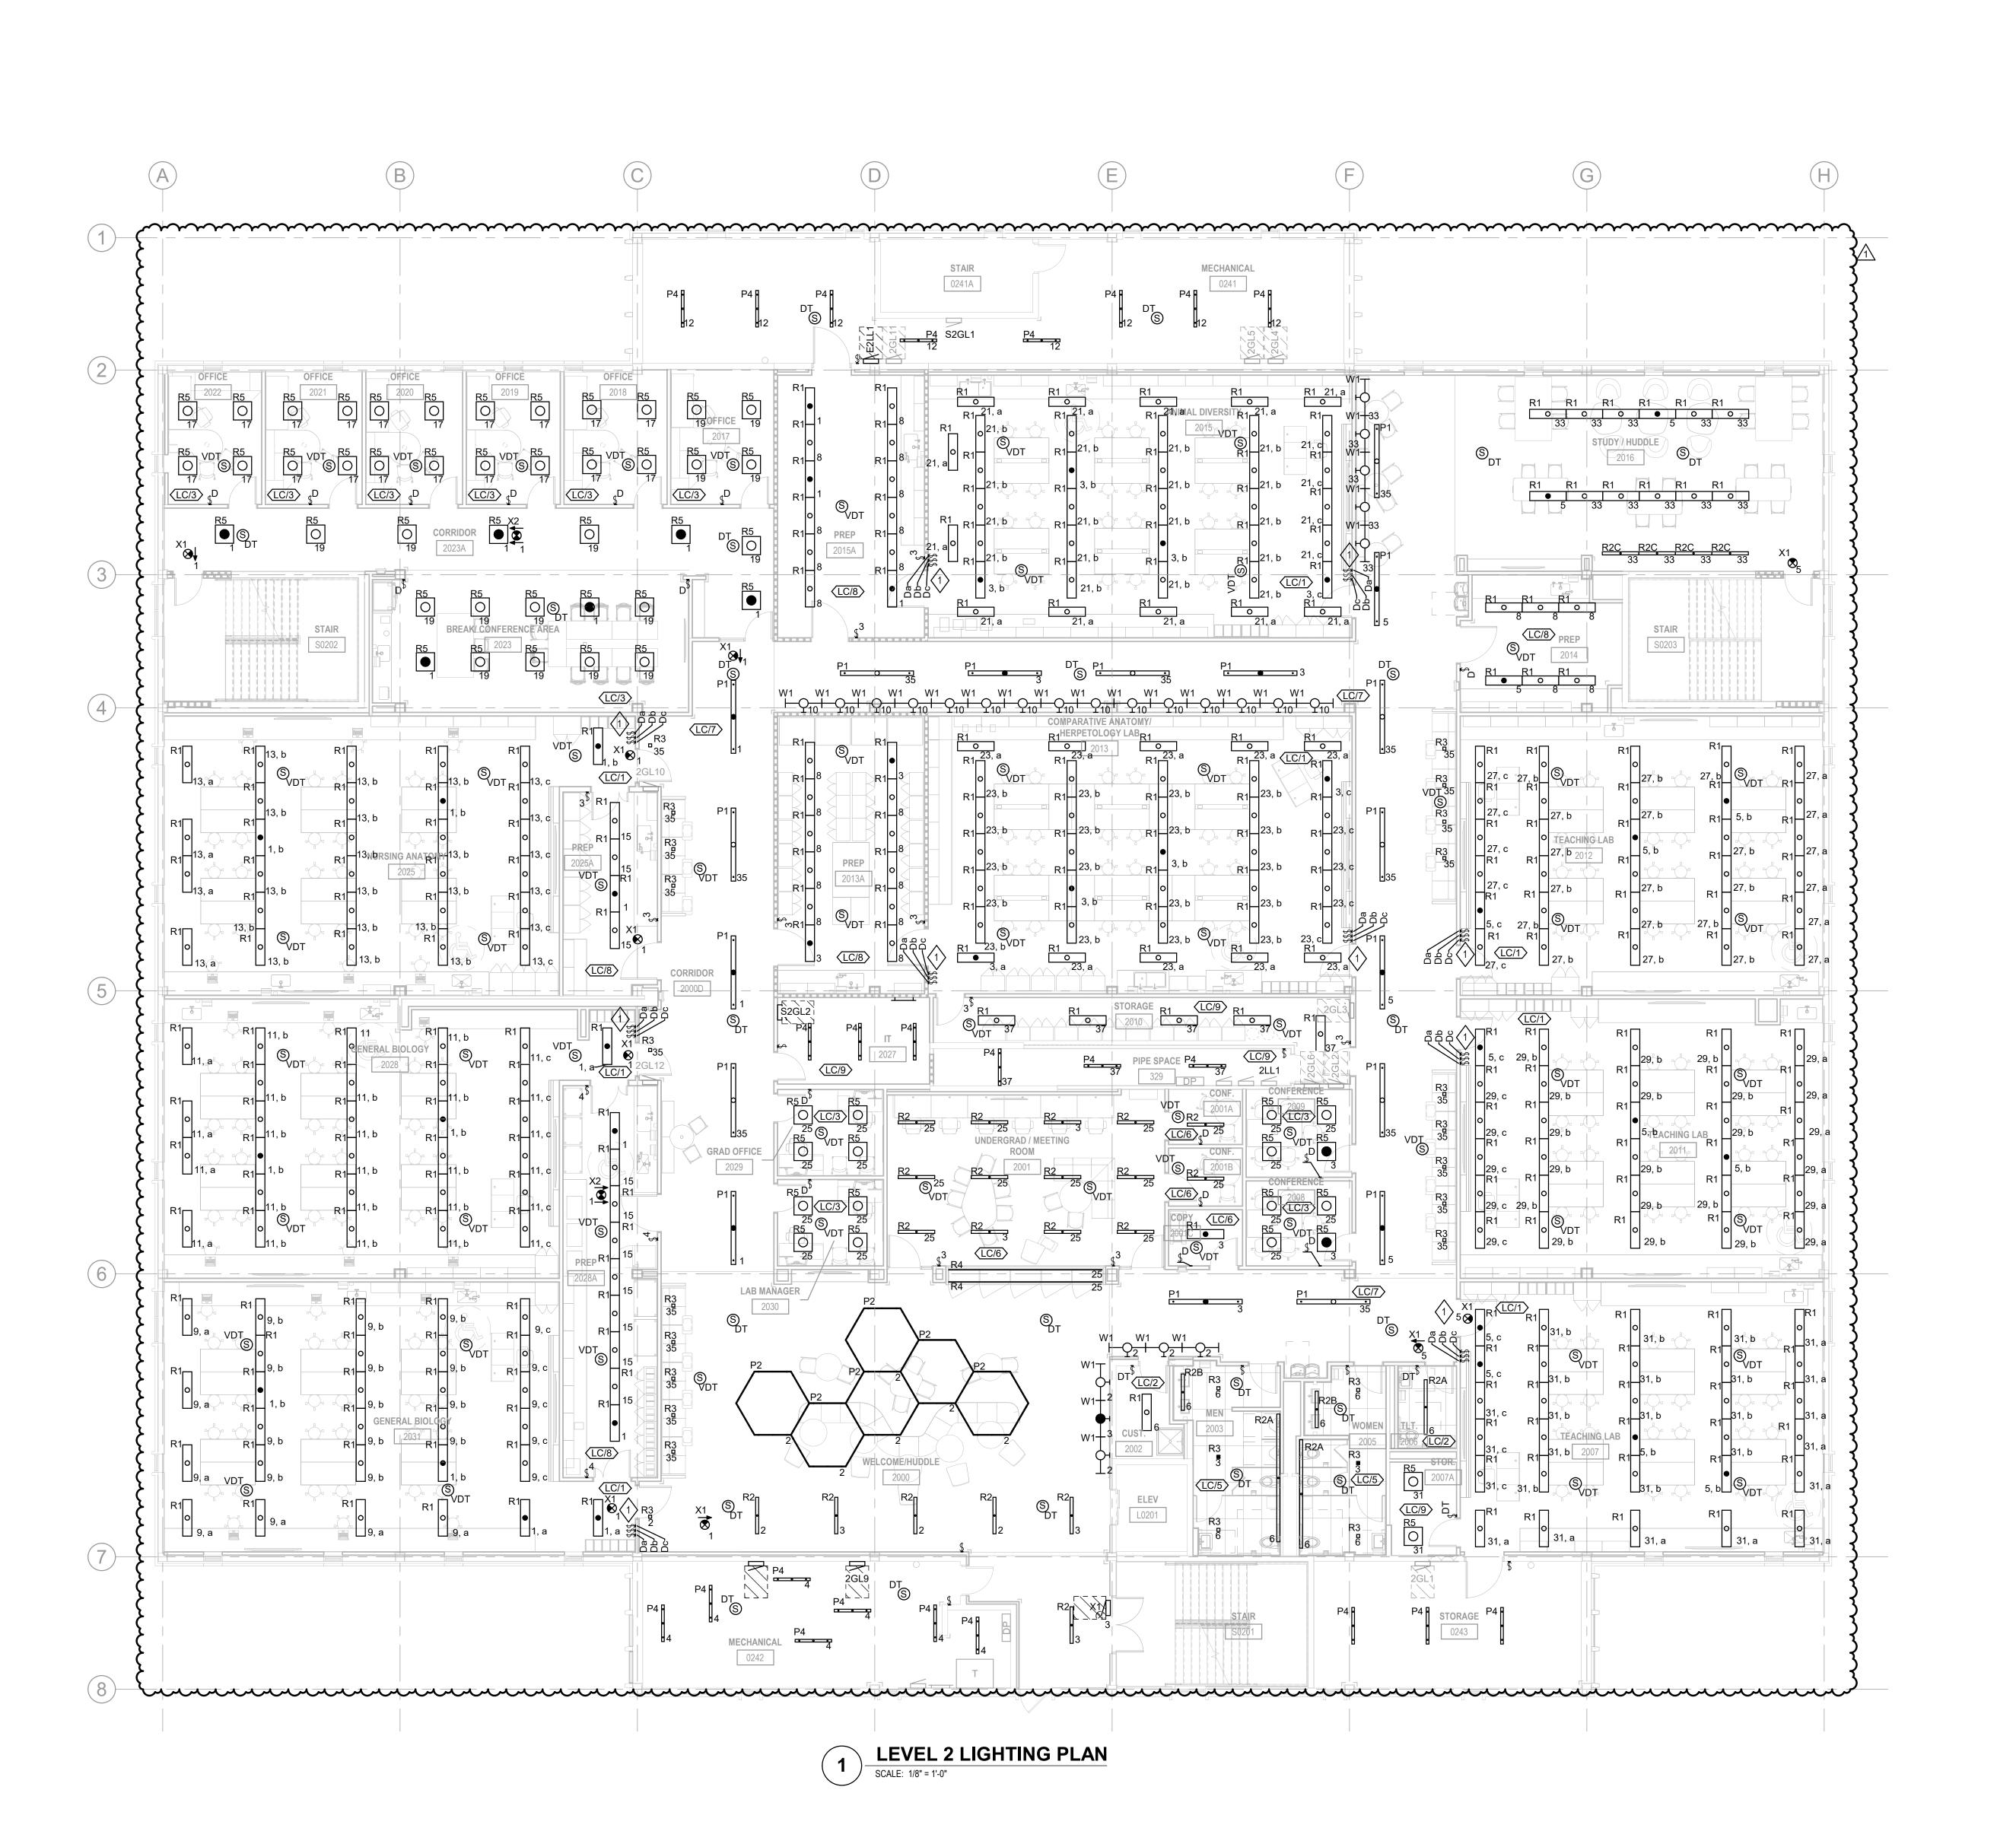

# **GENERAL NOTES**

- REFER TO SHEET E900 FOR LUMINAIRE SCHEDULE.
- COORDINATE ALL DEVICE AND LIGHT LOCATIONS WITH ARCHITECTURAL DRAWINGS AND DIAGRAMS PRIOR TO ROUGH-IN.
- 3. PROVIDE NEW NAME ENGRAVED COVERPLATES INDICATING SUPPLY PANEL AND CIRCUIT NUMBER(S) FOR ALL ELECTRICAL DEVICES IN THIS PROJECT. ENGRAVING SHALL BE RED FOR
- NORMAL POWER LIGHTING CIRCUITS SHALL BE SUPPLIED FROM PANEL 2LL1.

EMERGENCY AND BLACK FOR NORMAL CIRCUITS.

- 5. EMERGENCY POWER LIGHTING CIRCUITS SHALL BE SUPPLIED FROM PANEL E2LL1.
- 6. LIGHTING CONTROL "LC/X" TAGS ON PLANS INDICATE REQUIRED SYSTEM COMPONENTS FOR INTERIOR SPACES. REFER TO DETAILS FOR MORE INFORMATION.
- 7. EMERGENCY LIGHTS SHALL BE SWITCHED WITH NORMAL LIGHTS IN ALL AREAS UNLESS NOTED OTHERWISE. PROVIDE UL 924 EMERGENCY TRANSFER DEVICE TO FORCE AND HOLD LIGHTS ON UPON LOSS OF POWER.
- 8. EXIT SIGNS SHALL BE UNSWITCHED FOR CONTINUOUS OPERATION. PULL UNSWITCHED HOT CONDUCTOR FROM LOCAL LIGHTING CIRCUIT TO EXIT SIGNS.
- 9. INITIATION OF FIRE ALARM SYSTEM SHALL OVERRIDE OCCUPANCY SENSOR(S) CONTROLLING LIGHTS IN DESIGNATED EGRESS PATHWAYS AND FORCE ALL LIGHTS TO ON.

# **SHEET KEY NOTES**

 COORDINATE TEACHING LAB LIGHTING ZONES WITH FSU AV TEAM. Walker Architect

ARCHITECT

WALKER ARCHITECTS
2035 NW 13TH STREET

GAINESVILLE, FL 32609 352.672.6448 AA26002009

MEPF ENGINEER

AFFILIATED ENGINEERS
12921 SW 1 ROAD, #205
NEWBERRY, FL 32669

STRUCTURAL ENGINEER

352.376.5500

WALTER P. MOORE 201 E KENNEDY BLVD #700 TAMPA FL 33602 813.221.2424

SEAL AND SIGNATURE

ENGINEER OF RECORD
TOBY S. SMITH FL P.E NO. 71672

SUBMITTAL: ISSUE DATE:

CONSTRUCTION DOCUMENTS 08/12/2025

REVISION DESCRIPTION DATE

ADDENDUM-01

FSU BIO UNIT ONE TEACHING

**LABS** 

FLORIDA STATE UNIVERSITY, 89 CHIEFTAN WAY, TALLAHASSEE, FL 32304

KEY PLAN



DRAWING TITLE:

LEVEL 2 ELECTRICAL


LIGHTING PLAN

PROJECT NO.: 23055-00 DRAWN BY: CJYS
CHECKED BY: CRT

E102


		Cont	rol Uni	t Annu	ınciatio	n			Notifi	cation						Requ	ired fo	r Fire	Safety	Contr	ol				Supplementary	
		System Ou	ıtputs	_																_				_		
System Inputs	Number Identifier	Actuate Common Alarm Signal Indicator	Actuate Audible Alarm Signal	Actuate Common Supervisory Signal	Actuate Audible Supervisory Signal	Actuate Common Trouble Signal Indicator	Actuate Audible Trouble Signal	Actuate Appropriate Location Indicator	Actuate All Audible Evacuation Signals	Actuate All Visible Evacuation Signals	Outdoor Audible and/or Visual Device	Display/Print Change of Status	Transmit Alarm Signal to Supervising Station	Transmit Supervisory Signal to Supervising Sta.	Transmit Trouble Signal to Supervising Station	Release Magnetically Held Smoke Doors	Unlock Security Doors	Release Elevator Hiostway Vents	Elevator Shunt Trip	Recall Elevators To Primary Recall Floor	Recall Elevators to Alternate Recall Floor	Elevator Fire Hat Flash	Fan Shutdown	Damper Shutdown	Remotely Display Status	Number Identifier
		Α	В	С	D	E	F	G	Н	I	J	K	L	М	N	0	Р	Q	R	S	T	U	V	W	Y	
lanual Pull Station	1	Х	Х					Х	Х	Х		Х	Х			Х	Х								X	1
	2																									2
Smoke Detector General	3	Х	Х					Х	Х	Х		Х	Х			Х	Х								X	3
Smoke Detector at Door Hold Opens	4	Х	Х					Х	Х	Х		Х	Х			Х	Х								X	4
Smoke Detector Elev. Lobby Primary Floor	5	Х	Х					Х	Х	Х		Х	Х			Х	Х				Х					5
Smoke Detector Elev. Lobby All other Floors	6	Х	Х					Х	Х	Х		Х	Х			Х	Х			Х						6
Smoke Detector in Elev. Machine Room	7	Х	Х					Х	Х	Х		Х	Х			Х	Х					Х				7
Smoke Detector in Hoistway	8	Х	Х					Х	Х	Х		Х	Х			Х	Х					Х				8
	9																									9
Heat Detector General	10	Х	Х					Х	Х	Х		Х	Х			Х	Х								X	10
Heat Detector in Elev. Machine Room	11	Х	Х					Х	Х	Х		Х	Х			Х	Х		Х							11
Heat Detector in Hoistway	12	Х	Х					Х	Х	Х		Х	Х			Х	Х		Х							12
·	13																									13
Duct Mounted Smoke Detectors At Fire/Smoke Dampers	14			х	х			х				х		Х										х	х	14
AHU/RF Duct Mounted Smoke Detector	15			Х	Х			Х				Х		Х									Х		X	15
	16																									16
Post Indicator Valve Switch	17			Х	Х			Х				Х		Х											X	17
Sprinkler Main Waterflow	18	Х	Х					Х	Х	Х	Х	Х	Х			Х	Х								X	18
Sprinkler Atrium Waterflow	19	Х	Х					Х	Х	Х		Х	Х			Х	Х								X	19
Sprinkler Tamper Switch	20			Х	Х			Х				Х		Х											X	20
	21	1	İ								İ															21
ire Alarm AC Power Failure	22					Х	Х					Х			Х	Х		Х							X	22
ire Alarm Low Battery	23					Х	Х					Х			Х	1									Х	23
Open Circuit	24	1	1			Х	Х					Х			Х	1								1	X	24
Fround Fault	25		1			Х	Х				<b> </b>	Х			Х	†								1	X	25
	26	1																								26
levator Shunt Trip Monitor	27			Х	Х							Х		Х		1										27
	28	+	+	<u> </u>	<u> </u>				<del>                                     </del>	<del>                                     </del>	<del>                                     </del>		<del>                                     </del>	<b>——</b>	<del>                                     </del>	+	1	<del>                                     </del>	<b>-</b>		<del>                                     </del>	1	<del> </del>	+	+	28

SCALE: 12" = 1'-0"

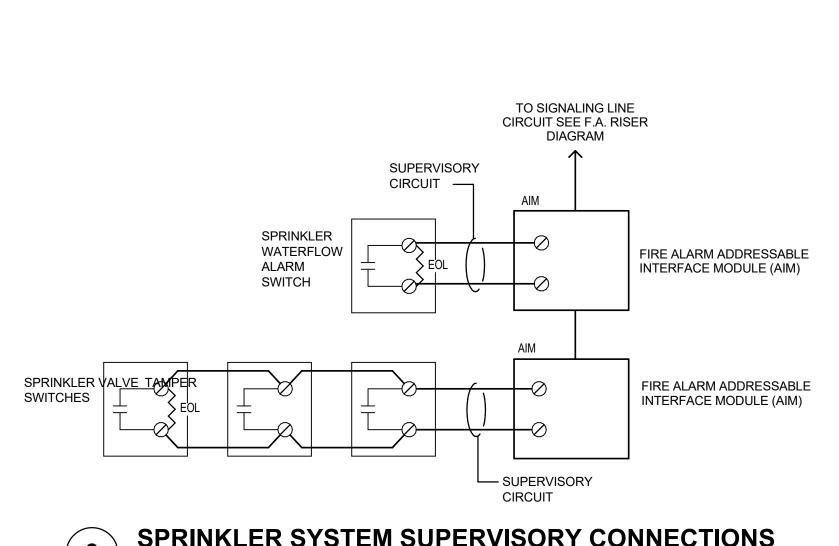

SPRINKLER SYSTEM SUPERVISORY CONNECTIONS

SCALE: 12" = 1'-0"

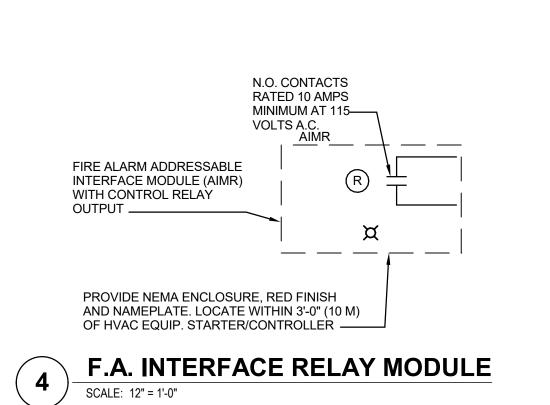

120V EMERGENCY POWER - (2)#10, (1) #10 GND IN 3/4"C TO NOTIFICATION APPLIANCES **APPLIANCES** EXTENDER PANEL WITH BATTERIES DEVICES SCOPE OF WORK 120V EMERGENCY POWER - E2LL1-2 (2)#10, (1) #10 GND IN 3/4"C NAC — TO NOTIFICATION APPLIANCES **APPLIANCES** EXTENDER PANEL WITH BATTERIES DEVICES 2ND FLOOR 120V EMERGENCY POWER - (2)#10, (1) #10 GND IN 3/4"C TO NOTIFICATION APPLIANCES TO NOTIFICATION APPLIANCES EXTENDER PANEL WITH BATTERIES OUTDOOR POST INDICATING VALVE SLC -TO INITIATING S——(S)——DEVICES → TO INITIATING DEVICES EMERGENCY LIGHTING CONTROLLER

SINTERFACE, TYPICAL EACH FLOOR FDC WP COMMUNICATIONS WIRING EXISTING "FACP" REMOTE LCD ANNUNCIATOR SS - SURGE SUPPRESSION MODULE (TYP.) PRE-ACTION FIRE ALARM SPRINKLER CONTROL PANEL NAC - CONVENTIONAL NOTIFICATION APPLIANCE CIRCUIT KELTRON REPORTING CABINET (NFPA 72 CLASS B, STYLE Y), 2#14 AWG TYPICAL VOICE/ALARM/ MASS SYSTEM MOUNT EQUIPMENT
NEXT TO MAIN FIRE
ALARM PANEL SLC - SIGNALING LINE CIRCUIT (NFPA 72 CLASS B, STYLE 4). NOTIFICATION TWISTED, SHIELDED PAIR COMMUNICATIONS WIRING CONTROL PANEL AND BATTERY DSM - DUAL-CIRCUIT SYNCHRONIZATION MODULE (TYP.) POWER SUPPLY 120V EMERGENCY POWER - "LOCK ON" CIRCUIT BREAKER ALARM TO DEPARTMENT OF PUBLIC SAFETY 2#10 + #10 GND, 3/4"C 1ST FLOOR

FIRE ALARM RISER DIAGRAM

**ARCHITECT** WALKER ARCHITECTS 2035 NW 13TH STREET GAINESVILLE, FL 32609 352.672.6448 AA26002009

**MEPF ENGINEER** 

352.376.5500

AFFILIATED ENGINEERS 12921 SW 1 ROAD, #205 NEWBERRY, FL 32669

STRUCTURAL ENGINEER WALTER P. MOORE 201 E KENNEDY BLVD #700 TAMPA FL 33602 813.221.2424

SEAL AND SIGNATURE

ENGINEER OF RECORD TOBY S. SMITH FL P.E NO. 71672

08/25/2025

ISSUE DATE: CONSTRUCTION DOCUMENTS 08/12/2025 DATE DESCRIPTION REVISION

ADDENDUM-01

**FSU BIO UNIT** ONE TEACHING **LABS** 

FLORIDA STATE UNIVERSITY, 89 CHIEFTAN WAY, TALLAHASSEE, FL 32304

KEY PLAN

DRAWING TITLE: FIRE ALARM RISER DIAGRAM, DETAILS, AND MATRIX

PROJECT NO.: 23055-00 DRAWN BY: CJYS CHECKED BY: CRT

	LUMINAIRE SCHEDULE														
						LAMP			DRIV	ER					
TYPE	DESCRIPTION	MANUFACTURER	MODEL NO.	TYPE	WATTS	COLOR TEMPERATURE	CRI	LUMENS	TYPE	VOLTAGE	MOUNTING	COMMENTS			
P1	8'L x 6" W LINEAR; SATIN WHITE OPTICS; MATTE WHITE FINISH; 0-10V DIMMING; MVOLT	LITHONIA LIGHTING	LSIX SERIES	LED	45 W	40K	80	6000	INTEGRAL	120 V	PENDANT AT 8' A.F.F.				
P2	4'L LINEAR; 2" APERTURE; SINGLE-SIDED ILLUMINATION	ALW LIGHTING	GO FIGURE RPD07 SERIES	LED	5 W	40K	90	500	INTEGRAL	120 V	PENDANT AT 8' A.F.F.				
P4	4'L LINEAR; FLAT DIFFUSE LENS; WHITE FINISH; STANDARD EFFICIENCY; 0-10V DIMMING	LITHONIA LIGHTING	CLX SERIES	LED	32 W	40K	80	4000	INTEGRAL	120 V	PENDANT				
R1	4'L x 1'W EDGE-LIT FLAT PANEL; SATIN WHITE LENS; 0-10V DIMMING; MVOLT;	LITHONIA LIGHTING	EPANL LED SERIES	LED	40 W	40K	80	4000	INTEGRAL	120 V	RECESSED				
R2	4'L x 4"W LINEAR FLUSH LENS; HIGH-EFFICIENCY LAMBERTIAN OPTIC; HIGH PERFORMANCE LED; UNV VOLTAGE; 0-10V DIMMING; MATTE WHITE FINISH; T-BAR GRID MOUNTING	LUMENWERX	VIA 4 LED SERIES	LED	16 W	40K	80	500	INTEGRAL	120 V	RECESSED	WATTAGE AND LUMEN OUTPUT FOR FIXTURE IS PER FOO			
R2A	4"W LINEAR FLUSH LENS; HIGH-EFFICIENCY LAMBERTIAN OPTIC; HIGH PERFORMANCE LED; UNV VOLTAGE; 0-10V DIMMING; MATTE WHITE FINISH; PROVIDE CONTINUOUS ROW WHERE LENGTH EXCEEDS 4'; T-BAR GRID MOUNTING	LUMENWERX	VIA 4 LED SERIES	LED	16 W	40K	80	500	INTEGRAL	120 V	RECESSED	WATTAGE AND LUMEN OUTPUT FOR FIXTURE IS PER FOO			
R2B	4'L x 4"W LINEAR FLUSH LENS; HIGH-EFFICIENCY LAMBERTIAN OPTIC; HIGH PERFORMANCE LED; UNV VOLTAGE; 0-10V DIMMING; MATTE WHITE FINISH; VISIBLE FLANGE FOR MOUNTING IN DRYWALL CEILING	LUMENWERX	VIA 4 LED SERIES	LED	16 W	40K	80	500	INTEGRAL	120 V	RECESSED	WATTAGE AND LUMEN OUTPUT FOR FIXTURE IS PER FOO			
R2C	4'L x 4"W LINEAR FLUSH LENS; WALL WASH REFRACTIVE OPTIC; HIGH PERFORMANCE LED; UNV VOLTAGE; 0-10V DIMMING; MATTE WHITE FINISH; T-BAR GRID MOUNTING	LUMENWERX	VIA 4 LED SERIES	LED	16 W	40K	80	500	INTEGRAL	120 V	RECESSED				
R3	4" SQUARE DOWNLIGHT; CLEAR TRIM; SEMI-SPECULAR FINISH; 0-10V DIMMING; MVOLT	LITHONIA LIGHTING	LDN4SQ SERIES	LED	25 W	40K	80	2000	INTEGRAL	120 V	RECESSED				
R4	STATIC WHITE STANDARD LED STRIP; DRY RATED; LATO RECESSED HOUSING WITH A BLACK FINISH; SST MOUNTING; DIFFUSED LENS	QT LIGHTING	SD-SW SERIES	LED	8 W	40K	97	593	INTEGRAL	120 V	RECESSED	LUMEN OUTPUT FOR FIXTURE IS PER FOOT			
R5	2' X 2' EDGE-LIT FLAT PANEL; SATIN WHITE LENS; 0-10V DIMMING; MVOLT	LITHONIA LIGHTING	EPANL LED SERIES	LED	31 W	40K	80	3364	INTEGRAL	120 V	RECESSED				
W1	4'L SINGLE WALL MOUNT ADJUSTABLE LED CANTILIEVERED FIXTURE, INSTALLED IN CONTINUOUS RUN	DELRAY LIGHTING	STICK SLT9 BARE SERIES	LED	28 W	40K	90	2886	INTEGRAL	120 V	WALL, SURFACE AT 8' A.F.F.				
X1	SINGLE FACE; WHITE DIE-CAST ALUMINUM HOUSING; RED LETTERS	LITHONIA LIGHTING	LQC SERIES	LED	1 W				INTEGRAL	120 V	RECESSED				
X2	DOUBLE FACE; WHITE DIE-CAST ALUMINUM HOUSING; RED LETTERS	LITHONIA LIGHTING	LQC SERIES	LED	1 W				INTEGRAL	120 V	RECESSED				

										EQUIPM	IENT SCHEDULE									
EQUIPMENT					MC	OTOR/EQUIPMEN	IT DATA			CIRCUIT INFORM	IATION		CONDUIT	AND WIRE REQ	UIREMENTS			CONTROLLER/DIS	CONNECT INFORM	ATION
						APPARENT						PARALLEL	# OF CONDUCTORS	CONDUCTOR	GROUND CTOR CONDUCTOR SIZE			PROVISION OF ROLS/CONTROLLER PROVISION OF DISCONNECTING ME		
EQ. TAG	EQ. ID	DESCRIPTION	LEVEL	VOLTAGE	PHASE	LOAD (kVA)		MCA (A)	PANEL	CIRCUIT#	CB SIZE	SET		SIZE		CONDUIT SIZE	DIV 26	OTHER DIVISION	BY DIV 26	OTHER DIVISION
AHU	2-2	AIR HANDLING UNIT	LEVEL 2	480 V	3	18.30 kVA	22 A	28 A	S3MH1	50,52,54	50 A	1 SET	3	#6	#10	1" C	-	VFD BY DIV. 23	-	DISCONNECT WITH VFD BY DIV. 23
RF	2-1	RETURN FAN	LEVEL 2	480 V	3	2.83 kVA	3 A	4 A	S3MH1	43,45,47	15 A	1 SET	3	#12	#12 G	3/4" C	-	VFD BY DIV. 23	-	DISCONNECT WITH VFD BY DIV. 23
GEF	2-1	GENERAL EXHAUST FAN	ROOF	120 V	1	1.18 kVA	10 A	12 A	S3ML2	6	15 A	1 SET	2	#12	#12 G	3/4" C	-	CONTROLS BY DIV.	20A MOTOR-RATED TOGGLE SWITCH	-
LEF	2-2	LAB EXHAUST FAN	ROOF	480 V	3	22.45 kVA	27 A	34 A	S3MH1	31,33,35	60 A	1 SET	3	#8	#10 G	3/4" C	-	VPDBVBN/28~~	100A/3P/NF/N3R	-
LEF	2-1	LAB EXHAUST FAN	ROOF	480 V	3	22.45 kVA	27 A	34 A	S3MH1	25,27,29	60 A	1 SET	3	#4	#10 G	3/4" C	-	VFD BY DIV. 23	100A/3P/NF/N3R	-
AHU	2-1	PACKAGED AIR HANDLING UNIT	LEVEL 2	480 V	3	43.23 kVA	52 A	65 A	S3MH1	44,46,48	110 A	1 SET	3	#1	#6 G	1" C	-	VFD BY DIV. 23	-	DISCONNECT WITH VFD BY DIV. 23
ERP	2-1	ENERGY RECOVERY PUMP	LEVEL 2	208 V	2	1.44 kVA	5 A	6 A	\$3ML2	35,37	15 A	1 SET	2	#12	#12 G	3/4" C	-	CONTROLS BY DIV. 23	-	-
FCU	2-1	FAN COIL UNIT	LEVEL 2	120 V	1	0.50 KVA	444	U SAUCE	S3ML2	16	20 A	1 SET	2	#12	#12 G	3/4" C	-	CONTROLS BY DIV. 23	-	DISCONNECT SWITCH FURNISHED WITH UNIT UNDER DIVISION 23
GMU	1	GLYCOL MAKE-UP	LEVEL 2	120 V	1	0.86 kVA	7 A	9 A	S3ML2	18	15 A	1 SET	2	#12	#12 G	3/4" C	-	CONTROLS BY DIV. 23	-	DISCONNECT SWITCH FURNISHED WITH UNIT UNDER DIVISION 23

**ARCHITECT** WALKER ARCHITECTS 2035 NW 13TH STREET GAINESVILLE, FL 32609 352.672.6448 AA26002009

**MEPF ENGINEER** AFFILIATED ENGINEERS 12921 SW 1 ROAD, #205 NEWBERRY, FL 32669 352.376.5500

STRUCTURAL ENGINEER WALTER P. MOORE 201 E KENNEDY BLVD #700 TAMPA FL 33602 813.221.2424

SEAL AND SIGNATURE

ENGINEER OF RECORD TOBY S. SMITH FL P.E NO. 71672

08/25/2025

SUBMITTAL:
CONSTRUCTION DOCUMENTS ISSUE DATE: 08/12/2025 DATE REVISION DESCRIPTION

ADDENDUM-01

**FSU BIO UNIT ONE TEACHING LABS** 

FLORIDA STATE UNIVERSITY, 89 CHIEFTAN WAY, TALLAHASSEE, FL 32304

ELECTRICAL SCHEDULES

PROJECT NO.: 23055-00 DRAWN BY: CJYS
CHECKED BY: CRT

**E900**